

# State Well Report

## Part 1

Mississippi Department of Environmental Quality  
Office of Land and Water Resources  
P.O. Box 10631  
Jackson, MS 39289-0631  
(601)961-5210  
(601)354-6938 (fax)

For Office Use Only:

Aquifer: \_\_\_\_\_  
Well #: J-89  
L. S. Elevation: \_\_\_\_\_  
E-log #: \_\_\_\_\_

County: Newton  
Permit #: \_\_\_\_\_  
Driller: Rayk West Drilling  
Date drilling completed: 2-19-05

State Law requires that this report be prepared by the driller in detail and filed with the Department within 30 days of completion of drilling of the well.

Well Owner Information	Well Location
Owner Name: <u>Keith Evans</u>	Latitude: <u>32° 22' 36"</u> Longitude: <u>89° 19' 13"</u>
Mailing Address: <u>892 Crosby Rd</u>	Method of Lat/Long (circle one): <u>Conventional Survey</u>
<u>Lake</u> MS <u>39092</u>	USGS quad, Hand-held GPS, Survey-grade GPS
City State Zip Code	<u>SW 1/4 NW 1/4 Sec 7 Twn 6N Rng 10E</u>
Telephone No. <u>(601) 775-3573</u>	Distance Direction Nearest Town Miles of

**Well Data**

Purpose of Well (circle one) Home Industrial Public Supply Irrigation Fish Culture Other: Poultry Farm

Date well drilling started: 2-18-05 Date well drilling completed: 2-19-05

If flowing, method of flow regulation: Valve \_\_\_\_\_ Other (describe) \_\_\_\_\_

Static Water Level: 115 feet above or below (circle one) land surface Date measured: 2-19-05

Method of Measurement (circle one) steel tape electric tape air line other: \_\_\_\_\_

Hole depth: 372 Well depth: 372 Well grouted to a depth of 10 feet

Type of grout (circle one): Cement Bentonite Mix

Casing length: 352 feet Casing diameter: 4 inches Type of casing: PVC

Screen length: 20 feet Screen diameter: 4 inches Type of screen: PVC slotted

Screen slot size: .010 inches Setting depth: From 352 feet to 372 feet

Type of completion (circle all applicable): Gravel packed Underreamed Telescoped Open hole Natural Development

Other (describe): \_\_\_\_\_

Top of lap pipe or reduction in casing: \_\_\_\_\_ feet. If telescoped or more than one screen, describe on back of page

Logs run (circle all applicable): No log run Electric Gamma Ray Density Sonic Neutron Other: \_\_\_\_\_

Name of organization running log(s): \_\_\_\_\_

I certify that the well was drilled, constructed, and completed in accordance with all applicable requirements of the Mississippi Department of Environmental Quality and/or the Mississippi Department of Health regulations and state laws.

David A. West 0-672

David A. West

Print Name of Water Well Contractor and License No.

Signature of Water Well Contractor

RECEIVED  
FEB 28 2005  
BY: OLWR

# STATE WELL REPORT

## Part 2

**Pump Installer's Completion Report**  
 Mississippi Department of Environmental Quality  
 Office of Land and Water Resources  
 P.O. Box 10631  
 Jackson, MS 39289-0631  
 (601)961-5210  
 (601)354-6938 (fax)

For Office Use Only:

Aquifer: \_\_\_\_\_

Well #: J-89

Elevation: \_\_\_\_\_

County: Newton  
 Permit #: \_\_\_\_\_  
 Driller: Ray V. West Drilling  
 Date completed: 2-19-05

This report should be prepared by the pump installer in detail and filed with the Department within 30 days of the installation of pump.

Well Owner Information	Well Location
Owner Name: <u>Keith Evans</u>	Latitude: <u>32°23'</u> Longitude: <u>89°17'</u>
Mailing Address: <u>892 Crosby Rd</u>	Method of Lat/Long (circle one): Conventional Survey,
<u>Lake</u> <u>MS</u> <u>39092</u>	USGS quad, Hand-held GPS, Survey-grade GPS
City State Zip Code	<u>SW</u> $\frac{1}{4}$ <u>NW</u> $\frac{1}{4}$ Sec <u>7</u> Twn <u>6N</u> Rng <u>10E</u>
Telephone No. <u>(601) 775-3573</u>	Distance Direction Nearest Town
	<u>2</u> Miles <u>N</u> of <u>Lake</u>

Pump Type Circle one	Power Type Circle one
Air Lift Jet <input checked="" type="radio"/> <u>Submersible</u>	Diesel Engine Gasoline Engine Natural Gas
Bucket Piston Turbine	<input checked="" type="radio"/> <u>Electric Motor</u> Hand Tractor PTO
Centrifugal Rotary Flowing Well	Windmill Other (specify): _____
Other (specify): _____	Horse Power Rating of Motor: <u>5</u>
Date Pump Installed: _____	Setting Depth: <u>180</u> feet
Rated Pump Capacity: <u>50</u> Gallons Per Minute	Number of Stages: <u>11</u>

Pump Test Data	Method of Measuring Water Level Circle one
Date Well Tested: _____	Air Line Electric Measuring Line Steel Tape
Static Water Level (A): _____ Feet Below Land Surface	Other (specify): _____
Pumping Water Level (B): _____ Feet Below Land Surface	For flowing well, measured shut in head: _____ feet
Drawdown [(B) - (A)]: _____ Feet Below Land Surface	Well yielded _____ GPM with a drawdown of
Test Pumping Rate: _____ Gallons Per Minute	_____ feet after _____ hours of pumping
Duration of Pump Test (minimum 4 hours): _____ hours	

I HEREBY CERTIFY that the above statements are true to the best of my knowledge.


David R. West 0-672 David R. West  
 Print Name of Pump Installer and License No. (if applicable) Signature of Pump Installer

**RECEIVED**  
 FEB 28 2005  
 BY: OLWR

If well telescopes please sketch below and show depths.

Ground Level J-89


---

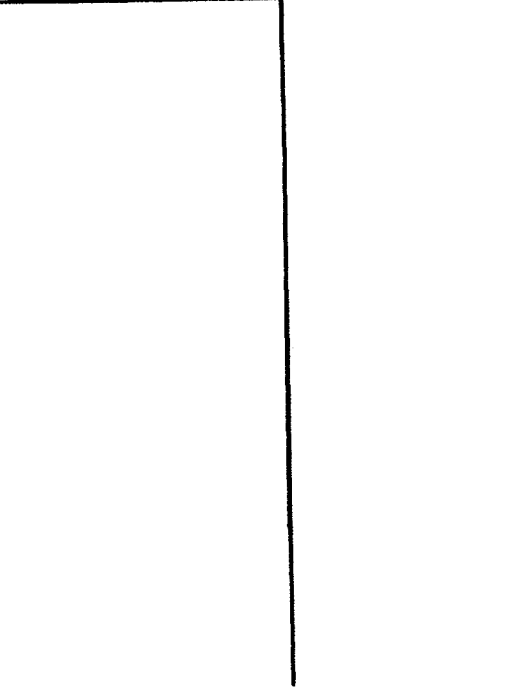

Description of Formations Encountered	From	To
CLAY	0	3
SAND - VERY FINE	3	132
CLAY & ROCK STRIPS	132	351
COARSE SAND	351	372

If more than one screen, show location of each on sketch

Sketch the property layout and include the following: 1) the well location; 2) any permanent structures on the property that may aid in locating the well; 3) any roads, power lines, or other items that may aid in locating the property and the well; 4) indicate direction.

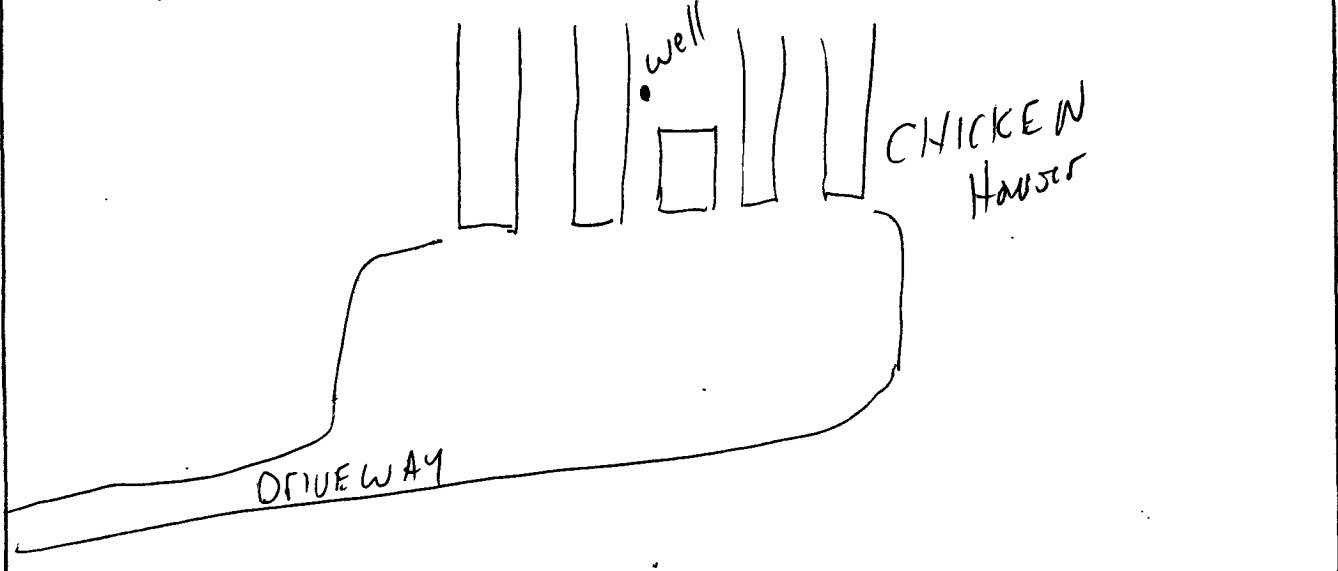

The sketch shows a property boundary with a driveway on the left side. In the center, there is a small square labeled 'well'. To the right of the well is a larger rectangular structure labeled 'CHICKEN HOUSE'.

Landowner Name: Keith Evans

*David H. West*  
Signature of Water Well Contractor

RECEIVED  
FEB 28 2005  
BY: OLWR