

Newton  
 J 2000  
 10-18-75

MISSISSIPPI  
 BOARD OF WATER COMMISSIONERS  
 416 North State Street  
 Jackson, Mississippi 39201

WATER WELL DRILLERS LOG

10-18-75 date well completed      U. L. Welch firm name      Newton county well located

LANDOWNER: Bennie Stewart  
Lawrence  
Miss  
 (mailing address)

Description of formations encountered	from	to
Clay	0	18
Sandy clay	18	40
Sand	40	118

WELL LOCATION:  
 sec. 15 T. 6N R. 10E 13T  
3 miles NW of Lawrence  
 (distance) (direction) (nearest town)

WELL PURPOSE: Home  
 (home, irrigation, municipal, industrial)


- WELL COMPLETION DATA:
- (1) diameter (inches) 3"
  - (2) total depth (feet) 118
  - (3) static water level (feet) 32 below top of ground.
  - (4) casing PVC (material), (depth)  
 \_\_\_\_\_ if telescope see back.  
 (size)
  - (5) screen 5' (length), (depth to top)  
3" (size), PVC (material)
  - (6) pump \_\_\_\_\_ (HP) \_\_\_\_\_ (yield gpm)  
pumping with  
 (type power)
  - (7) electric log no (yes or no)
  - \_\_\_\_\_ (organization running log)
  - (8) how well bottom plugged \_\_\_\_\_

DRILLERS REMARKS:

EXPIRES  
 NOV 6 1975  
 MISS. Bd. OF WATER COMMISSIONERS

If well telescopes please sketch and show depths.

GROUND LEVEL

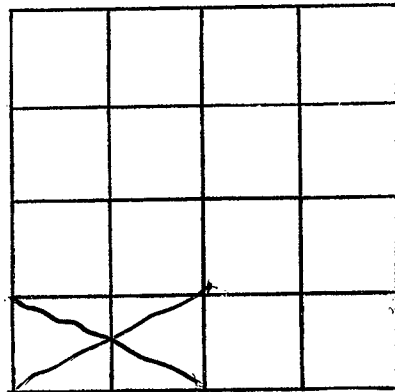

SECTION \_\_\_\_\_

Please indicate well location X.

ADDITIONAL INFORMATION


If more than one screen, show locations of each on sketch.