

NEWTON

J 2001

3-2-76

MISSISSIPPI BOARD OF WATER COMMISSIONERS 416 North State Street Jackson, Mississippi 39201

137

WATER WELL DRILLERS LOG

3-2

date well completed

1976 W.L. Welch Newton

firm name

county well located

LANDOWNER: W.L. Welch

description of formations encountered

from to

Lawrence

Red Clay

0 25

Miss

Sandy

25 40

(mailing address)

Blue

40 75

WELL LOCATION:

sec. 35 T 6 N R 10 E

Sand

120 194

1/2 miles N of Lawrence (distance) (direction) (nearest town)

WELL PURPOSE: Home (home, irrigation, municipal, industrial)

WELL COMPLETION DATA:

- (1) diameter (inches) 2"
(2) total depth (feet) 194
(3) static water level (feet) 48 below top of ground.

(4) casing PVC (material) (depth)
(size) if telescope see back.

(5) screen 10' (length) (depth to top)
2" PVC (size) (material)

(6) pump 1/2 (HP) 400 (yield gpm)
e (type power)

(7) electric log No (yes or no)

(organization running log)

(8) how well bottom plugged

DRILLERS REMARKS:


RECEIVED

MAR 16 1976

MISS. BD. OF WATER COMM.

If well telescopes please sketch and show depths.

GROUND LEVEL

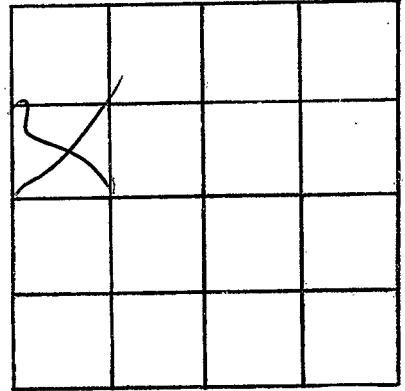

SECTION \_\_\_\_\_

Please indicate well location X.

ADDITIONAL INFORMATION

If more than one screen,  
show locations of each on sketch.