

NEWTON

MISSISSIPPI BOARD OF WATER COMMISSIONERS
416 North State Street
Jackson, Mississippi 39201

WATER WELL DRILLERS LOG

J 2002
2-23-76

13T

2-23
date well completed

1976 U. L. Welch
firm name

Newton
county well located

LANDOWNER: Gene Higgins

description of formations encountered

from

to

Lemona

yellow clay 0 30

Miss (mailing address)

white clay 30 40

WELL LOCATION:

sec 23 T 6 N R 10 E S
1 miles N of Lemona (distance) (direction) (nearest town)

sand blue 40 50

sand 50 160

WELL PURPOSE: Dairy farm (home, irrigation, municipal, industrial)

WELL COMPLETION DATA:

- (1) diameter (inches) 2"
- (2) total depth (feet) 160
- (3) static water level (feet) 45 below top of ground

(4) casing PVC (material), (depth) if telescope see back (size)


(5) screen 10' (length), (depth to top) 2" PVC (size) (material)

(6) pump 1 (HP), 600 (yield gpm) electric (type power)

(7) electric log yes (yes or no)

(organization running log)

(8) how well bottom plugged

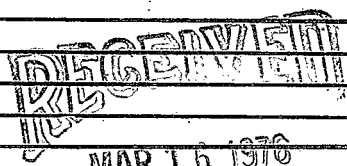

MAR 16 1976

DRILLERS REMARKS:

MISS. BD. OF WATER COMMISSIONERS

