

NEWTON  
J 2003  
9-1-76

MISSISSIPPI  
 BOARD OF WATER COMMISSIONERS  
 416 North State Street  
 Jackson, Mississippi 39201

WATER WELL DRILLERS LOG

9.1.76 <sup>13T</sup> 19 McDonald & Hill NEWTON  
 date well completed firm name county well located

LANDOWNER:  
L. J. Jacobs  
Rt 1 Lawrence  
 (mailing address)

WELL LOCATION:  
 sec. 21 T 14 N R. 10 E  
4 miles NORTH LAWRENCE  
 (distance) (direction) (nearest town)

WELL PURPOSE: HOME  
 (home, irrigation, municipal, industrial)

WELL COMPLETION DATA:

(1) diameter (inches) 4 1/2

(2) total depth (feet) 395'

(3) static water level (feet) 150' below above top of ground.

(4) casing PVC 380'  
 (material) (depth)  
4" if telescope see back.  
 (size)

(5) screen \_\_\_\_\_  
 (length) (depth to top)  
 (size) (material)

(6) pump 1 SUB 10  
 (HP) (yield gpm)  
E  
 (type power)

(7) electric log \_\_\_\_\_  
 (yes or no)  
 (organization running log)

(8) how well bottom plugged OPEN


description of formations encountered	from	to
Clay	0	10
Sand	10	55
Shale	55	110
Sandy shale	110	130
Shale	130	230
Sand	230	350
Soft shale	350	370
Hard to shale	370	380
Med shale	380	420
Gravel sand	420	500

DRILLERS REMARKS:

RECEIVED  
 SEP - 8 1976  
 MISS. BD. OF WATER COMMISSIONERS

If well telescopes please sketch and show depths.

GROUND LEVEL

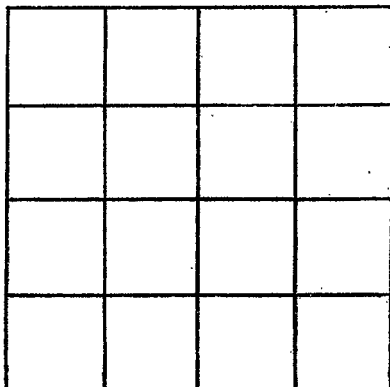

SECTION \_\_\_\_\_

Please indicate well location X.

ADDITIONAL INFORMATION

If more than one screen, show locations of each on sketch.