

Newton
J 2006
3-17-77

MISSISSIPPI
 BOARD OF WATER COMMISSIONERS
 416 North State Street
 Jackson, Mississippi 39201

WATER WELL DRILLERS LOG

3-17 1977 U.L. Stood Newton
 date well completed firm name county well located

LANDOWNER: B & W Fuel Service
LAWRENCE
MISS 39336
 (mailing address)

WELL LOCATION:
 sec. 36 T. 6 N R. 10 E
 S W
 _____ miles _____ of _____
 (distance) (direction) (nearest town)

WELL PURPOSE:
 (home, irrigation, municipal, industrial)

- WELL COMPLETION DATA:
- (1) diameter (inches) 4" + 2"
 - (2) total depth (feet) 182
 - (3) static water level (feet) 14 below top of ground.
 - (4) casing PVC (material), _____ (depth)
 _____ if telescope see back.
 (size)
 - (5) screen 10 (length) _____ (depth to top)
2 1/2" S. Steel
 (size) (material)
 - (6) pump 2 HP (HP) 1700 M (yield gpm)
plac
 (type power)
 - (7) electric log no (yes or no)
 _____ (organization running log)
 - (8) how well bottom plugged _____

Description of formations encountered	from	to
<u>Red Clay</u>	<u>0</u>	<u>22</u>
<u>Blue</u>	<u>22</u>	<u>40</u>
<u>Gray</u>	<u>40</u>	<u>100</u>
<u>Gray + Sand</u>	<u>100</u>	<u>170</u>
<u>Sand</u>	<u>170</u>	<u>182</u>



RECEIVED

MAR 18 1977

DRILLERS REMARKS:

MISS. BD. OF WATER COMM.

If well telescopes please sketch and show depths.

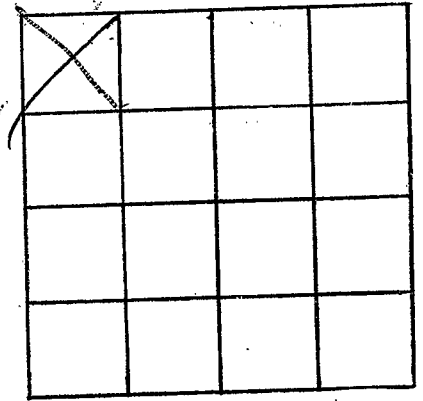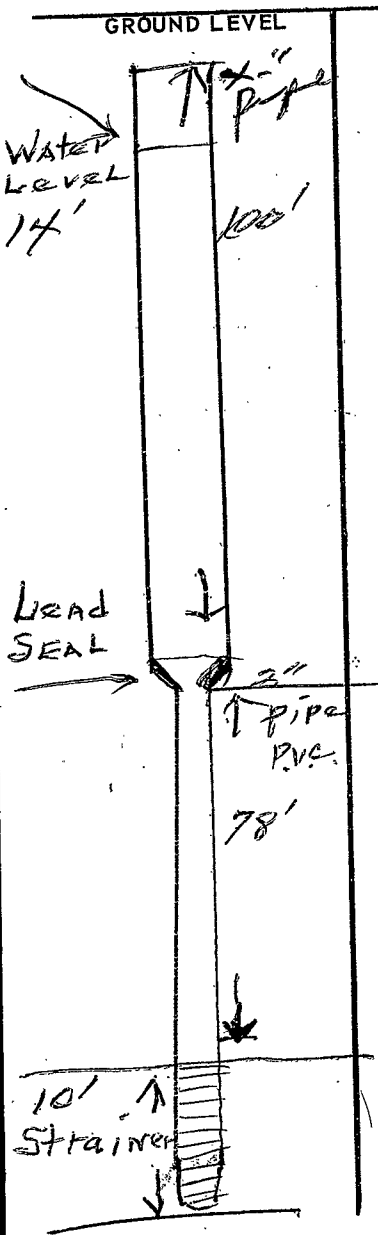

SECTION _____

Please indicate well location X.

ADDITIONAL INFORMATION

Blank lined area for providing additional information.

If more than one screen, show locations of each on sketch.