

NEWTON
J 2007
6-18-77

MISSISSIPPI
 BOARD OF WATER COMMISSIONERS
 416 North State Street
 Jackson, Mississippi 39201

WATER WELL DRILLERS LOG

6-18-77 19 McDonald & Hill Newton
 date well completed firm name county well located


LANDOWNER:	description of formations encountered	from	to
<u>Hamp Lowell Lawrence</u> (mailing address)	<u>clay & sand</u>	<u>0</u>	<u>25</u>
	<u>shale</u>	<u>25</u>	<u>58</u>
WELL LOCATION: sec. <u>36</u> T. <u>6</u> N. R. <u>10</u> E <u>1</u> miles <u>S</u> of <u>Lawrence</u> (distance) (direction) (nearest town)	<u>sand & shale</u>	<u>50</u>	<u>140</u>
	<u>sand</u>	<u>140</u>	<u>185</u>
	<u>shale</u>	<u>185</u>	<u>215</u>
WELL PURPOSE: <u>Home</u> (home, irrigation, municipal, industrial)	<u>sandy & pink</u>	<u>215</u>	<u>275</u>
WELL COMPLETION DATA:	<u>sand & shells</u>	<u>275</u>	<u>285</u>
(1) diameter (inches) <u>4"</u>	<u>shale & sand</u>	<u>285</u>	<u>330</u>
(2) total depth (feet) <u>1070'</u>	<u>sand</u>	<u>330</u>	<u>500</u>
(3) static water level (feet) <u>120'</u> below top of ground.	<u>sandy shale</u>	<u>500</u>	<u>545</u>
(4) casing <u>PVC</u> , <u>550'</u> (material) (depth)	<u>shale</u>	<u>545</u>	<u>600</u>
<u>4"</u> if telescope see back. (size)	<u>pink & shale</u>	<u>600</u>	<u>645</u>
(5) screen <u>10'</u> , <u>660 to 670'</u> (length) (depth to top)	<u>green</u>	<u>645</u>	<u>670</u>
<u>2"</u> , <u>PVC</u> (size) (material)			
(6) pump <u>1/2</u> , <u>600</u> (HP) (field gpm)			
<u>E</u> (type power)			
(7) electric log <u>✓</u> (yes or no)			
(organization running log)			
(8) how well bottom plugged <u>value</u>			
DRILLERS REMARKS:			

RECEIVED
 JUN 28 1977

MISS. Bd. OF WATER COMMISSIONERS

If well telescopes please sketch and show depths.

GROUND LEVEL

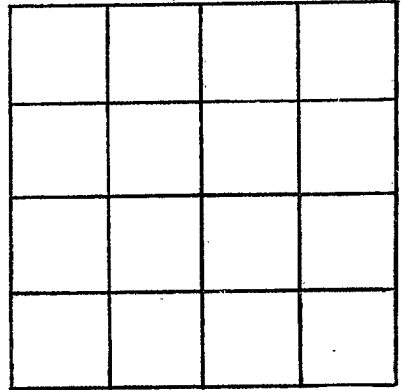

SECTION _____

Please indicate well location X.

ADDITIONAL INFORMATION

If more than one screen, show locations of each on sketch.