

NEWTON  
J 2009  
10/13/77

MISSISSIPPI  
 BOARD OF WATER COMMISSIONERS  
 416 North State Street  
 Jackson, Mississippi 39201

WATER WELL DRILLERS LOG

10-13-77 19 Mc Dona Hill Newton  
 date well completed firm name county well located


LANDOWNER:	description of formations encountered	from	to
<u>U.L.</u> <u>James E. Welch</u>	<u>clay &amp; sand</u>	<u>0</u>	<u>20</u>
<u>Rt #1 Lawrence</u> (mailing address)	<u>sand</u>	<u>20</u>	<u>115</u>
<b>WELL LOCATION:</b>			
sec. <u>24</u> T <u>6</u> N R <u>10</u> E <u>8 1/2</u> miles <u>N</u> of <u>Lawrence</u> (distance) (direction) (nearest town)			
<b>WELL PURPOSE:</b> <u>dom.</u> (home, irrigation, municipal, industrial)			
<b>WELL COMPLETION DATA:</b>			
(1) diameter (inches) <u>2"</u>			
(2) total depth (feet) <u>115'</u>			
(3) static water level (feet) <u>43'</u> below above top of ground.			
(4) casing <u>PVC</u> , <u>110'</u> (material) (depth) <u>2"</u> if telescope see back. (size)			
(5) screen <u>10'</u> , <u>115 to 110'</u> (length) (depth to top) <u>2</u> , <u>PVC</u> (size) (material)			
(6) pump <u>1/2</u> , <u>3 G.P.M.</u> (HP) (yield gpm) <u>E</u> (type power)			
(7) electric log _____ (yes or no)			
(organization running log)			
(8) how well bottom plugged <u>water</u>			
DRILLERS REMARKS:			

**RECEIVED**  
 OCT 25 1977

MISSISSIPPI BOARD OF WATER COMMISSIONERS

If well telescopes please sketch and show depths.

GROUND LEVEL

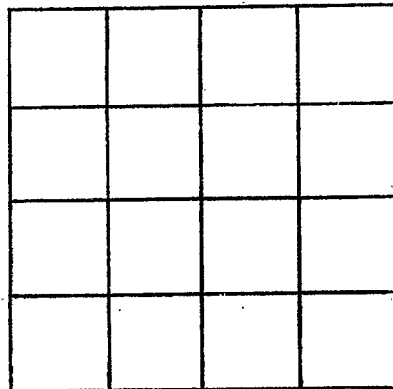

SECTION \_\_\_\_\_

Please indicate well location X.

ADDITIONAL INFORMATION

If more than one screen, show locations of each on sketch.