

NEWTON

J 2013

9-8-78

MISSISSIPPI  
BOARD OF WATER COMMISSIONERS  
416 North State Street  
Jackson, Mississippi 39201

WATER WELL DRILLERS LOG

9-8-78  
date well completed

McDonald & Hill  
firm name

Newton  
county well located


LANDOWNER:	description of formations encountered	from	to
Dan Beard	clay	0	20
Lourence (mailing address)	clay + sand	20	45
WELL LOCATION:	shale + lignite	45	140
sec. 36 T 6 N R 10 E 1/2 miles S of Lourence	shale + sand	140	160
(distance) (direction) (nearest town)	sand	160	205
WELL PURPOSE: none (home, irrigation, municipal, industrial)	shale	205	225
WELL COMPLETION DATA:	sandy shale	225	300
(1) diameter (inches) 4"	shale + sand	300	370
(2) total depth (feet) 680'	sand + shal.	370	440
(3) static water level (feet) 145' below top of ground.	sand	440	520
(4) casing PVC 580' (material) (depth)	sandy shale	520	560
4" if telescope see back. (size)	shale	560	617
(5) screen 10' 665 to 675' (length) (depth to top)	Rock + shale	617	665
2" PVC (size) (material)	green sand	665	680
(6) pump 1 1/2 209 PM (HP) (yiel'd gpm)			
F (type power)			
(7) electric log _____ (yes or no)			
(organization running log)			
(8) how well bottom plugged value			
DRILLERS REMARKS:			

RECEIVED  
SEP 18 1978

MISS. BD. OF WATER COMM.

If well telescopes please sketch and show depths.

GROUND LEVEL

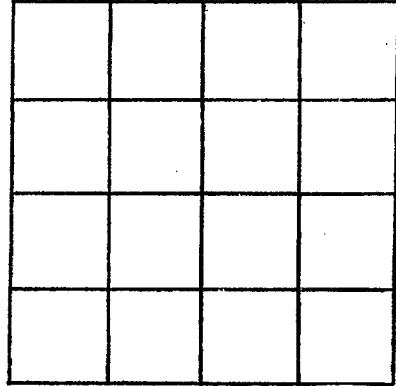

SECTION \_\_\_\_\_

Please indicate well location X.

ADDITIONAL INFORMATION

If more than one screen, show locations of each on sketch.