

NEWTON

J 2017

8/13/79

MISSISSIPPI BOARD OF WATER COMMISSIONERS 416 North State Street Jackson, Mississippi 39201

WATER WELL DRILLERS LOG

8-13-79 date well completed

McDonald + Hill firm name

Newton county well located

LANDOWNER:	description of formations encountered	from	to
Elton McNamee	clay + sand	0	10
Rt # 1 Decatur (mailing address)	sand	10	45
WELL LOCATION:	shale	45	90
sec. 13 T 6 N R 10 E 6 miles NW of Newton (distance) (direction) (nearest town)	sandy shale + sand	90	155
WELL PURPOSE:	shale + sand	155	225
(home, irrigation, municipal, industrial)	sand	225	350
WELL COMPLETION DATA:	sandy shale	350	370
(1) diameter (inches) 4"	shale	370	420
(2) total depth (feet) 480'	rocks + shells	420	450
(3) static water level (feet) 125' below top of ground.	green sand + sand	450	480
(4) casing PVC 400' (material) (depth)	shale		
4" (size) if telescope see back.			
(5) screen (length) (depth to top)			
(size) (material)			
(6) pump 3/4 100 gpm (HP) (yield gpm)			
(type power) E			
(7) electric log (yes or no)			
(organization running log)			
(8) how well bottom plugged OPEN			
DRILLERS REMARKS:			


Miss. Board of Water Comm.

AUG 22 1979

RECEIVED

If well telescopes please sketch and show depths.

GROUND LEVEL

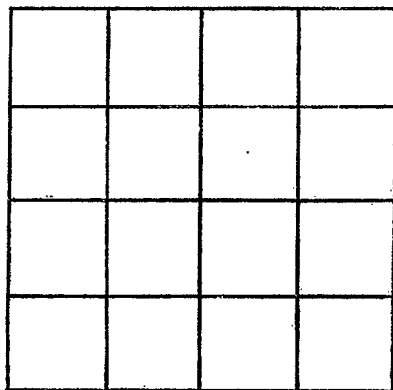

SECTION _____

Please indicate well location X.

ADDITIONAL INFORMATION

If more than one screen, show locations of each on sketch.