

NEWTON

J 2018

8/15/79

MISSISSIPPI BOARD OF WATER COMMISSIONERS 416 North State Street Jackson, Mississippi 39201

WATER WELL DRILLERS LOG

8-15-79 date well completed

McDonald & Hill firm name

Newton county well located

LANDOWNER:

Thomas Mitchell Rt # 1 Lawrence (mailing address)

description of formations encountered

from 0 to 15

clay & sand, sand & clay

WELL LOCATION:

sec. 14 T 6 N R 18 E 3 miles N of Lawrence (distance) (direction) (nearest town)

shale 85 120

sandy shale 120 175

WELL PURPOSE: (home, irrigation, municipal, industrial)

shale & sand 175 270

sand 270 370

WELL COMPLETION DATA:

- (1) diameter (inches) 4"
(2) total depth (feet) 520
(3) static water level (feet) 140' below top of ground.
(4) casing PVC 450' (material) (depth) 4" (size) if telescope see back.
(5) screen (length) (depth to top) (size) (material)
(6) pump 3/4 10 GPM (HP) (yield/gpm) E (type power)
(7) electric log (yes or no) (organization running log)
(8) how well bottom plugged open

sandy shale 370 410

shale 410 459

Rock & shells 459 495

green sand & sand, shale 495 520

Miss. Board of Water Comm.


AUG 22 1979

RECEIVED

DRILLERS REMARKS:

If well telescopes please sketch and show depths.

GROUND LEVEL

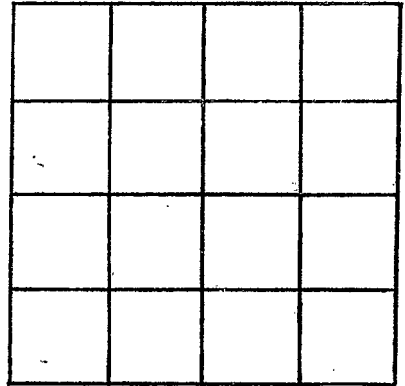

SECTION \_\_\_\_\_

Please indicate well location X.

ADDITIONAL INFORMATION

If more than one screen, show locations of each on sketch.