

Newton  
J 2019

MISSISSIPPI  
BOARD OF WATER COMMISSIONERS  
416 North State Street  
Jackson, Mississippi 39201

10-4-79  
10-4-79  
date well completed

WATER WELL DRILLERS LOG

McDonald & Hill  
firm name

Newton  
county well located

LANDOWNER:	description of formations encountered	from	to
<u>Cabin Evans</u>	<u>clay</u>	<u>0</u>	<u>12</u>
<u>Rt # 1 Decatur</u> (mailing address)	<u>sand &amp; clay</u>	<u>12</u>	<u>40</u>
WELL LOCATION: sec <u>2</u> T <u>6N</u> R <u>10E</u> <u>8</u> miles <u>NW</u> of <u>Newton</u> (distance) (direction) (nearest town)	<u>shale</u>	<u>40</u>	<u>50</u>
	<u>sand</u>	<u>50</u>	<u>70</u>
WELL PURPOSE: <u>home</u> (home, irrigation, municipal, industrial)	<u>sandy shale</u>	<u>70</u>	<u>140</u>
WELL COMPLETION DATA:	<u>sand &amp; shale</u>	<u>140</u>	<u>320</u>
(1) diameter (inches) <u>4"</u>	<u>sand</u>	<u>320</u>	<u>315</u>
(2) total depth (feet) <u>460</u>	<u>shale</u>	<u>315</u>	<u>335</u>
(3) static water level (feet) <u>160'</u> below top of ground.	<u>sandy shale</u>	<u>335</u>	<u>360</u>
(4) casing <u>PVC</u> , <u>390'</u> (material) (depth)	<u>shale</u>	<u>360</u>	<u>406</u>
<u>4"</u> (size) if telescope see back.	<u>Rock &amp; shells</u>	<u>406</u>	<u>435</u>
(5) screen _____ (length) (depth to top)	<u>green sand &amp; sandy shale</u>	<u>435</u>	<u>460</u>
(size) (material)			
(6) pump <u>34</u> <u>1000</u> (HP) (yield gpm)			
(type power)			
(7) electric log _____ (yes or no)			
(organization running log)			
(8) how well bottom plugged <u>open</u>			
DRILLERS REMARKS:			


DEPT. OF NATURAL RESOURCES  
BUREAU OF LAND & WATER RESOURCES

OCT 9 1979

RECEIVED

If well telescopes please sketch and show depths.

GROUND LEVEL

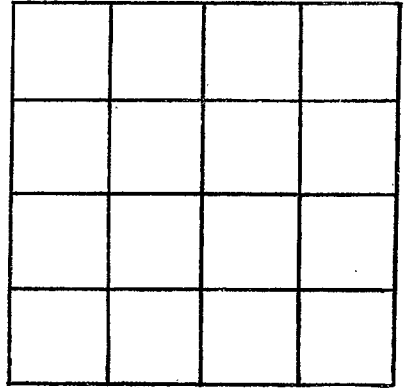

SECTION \_\_\_\_\_

Please indicate well location X.

ADDITIONAL INFORMATION

If more than one screen,  
show locations of each on sketch.