

Newton  
J 2020  
4/30/80

MISSISSIPPI  
 BOARD OF WATER COMMISSIONERS  
 416 North State Street  
 Jackson, Mississippi 39201

WATER WELL DRILLERS LOG

19 81 WILKERSON DRILLING NEWTON  
 firm name county well located

date well completed  
4/30/81

LANDOWNER: A.C. BELL  
LAWRENCE  
MISSISSIPPI  
 (mailing address)

description of formations encountered	from	to
Red CLAY + Red SAND	0	65
dark Brown clay	65	120
SANDY SHELL CLAY	120	248
WATER BEARING SAND	248	266

WELL LOCATION:

sec. 2 T. 6 N R. 10 E  
 S W  
8 miles NORTH of LAWRENCE  
 (distance) (direction) (nearest town)

WELL PURPOSE: DOMESTIC  
 (home, irrigation, municipal, industrial)

WELL COMPLETION DATA:

- (1) diameter (inches) 2"
- (2) total depth (feet) 266'
- (3) static water level (feet) 90 1/2 below above top of ground.
- (4) casing SCH 40 256  
 (material) (depth)  
 (size) If telescope see back.
- (5) screen 10' 256  
 (length) (depth to top)  
2" PLASTIC  
 (size) (material)
- (6) pump 3 15  
 (HP) (yield gpm)
- ELECT  
 (type power)
- (7) electric log No  
 (yes or no)

(organization running log)

(8) how well bottom plugged CAP

DRILLERS REMARKS:


DEPT. OF NATURAL RESOURCES  
 BUREAU OF LAND & WATER RESOURCES

MAY 18 1981

RECEIVED

If well telescopes please sketch and show depths.

GROUND LEVEL

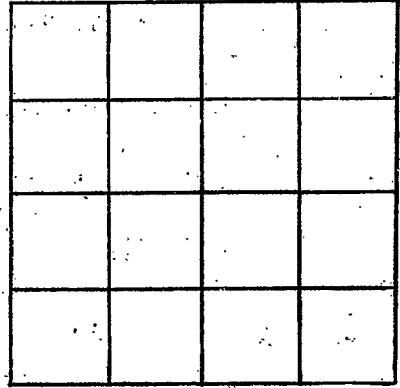

SECTION \_\_\_\_\_

Please indicate well location X.

ADDITIONAL INFORMATION

If more than one screen, show locations of each on sketch.