

MISSISSIPPI DEPARTMENT OF NATURAL RESOURCES

Bureau of Land and Water Resources

Southport Mall

P.O. Box 10631

Jackson, Mississippi 39209

WATER WELL DRILLERS LOG

Newton
J 2022
8-8-80

8-8-80 19 McDonald & Hill Newton
date well completed firm name county well located

LANDOWNER:	description of formations encountered	from	to
Cl. Don Thornton Jr. Rt # 1 Lawrence (mailing address)			
WELL LOCATION: sec. <u>14</u> T. <u>6</u> N. R. <u>10</u> E. <u>4</u> miles <u>N</u> of <u>Lawrence</u> (distance) (direction) (nearest town)	clay	0	12
WELL PURPOSE: <u>home</u> (home, irrigation, municipal, industrial)	sand	12	8.5
WELL COMPLETION DATA: (1) diameter (inches) <u>4"</u> (2) total depth (feet) <u>500'</u> (3) static water level (feet) <u>125'</u> below top of ground. (4) casing <u>PVC</u> <u>455'</u> (material) (depth) <u>4"</u> If telescope see back. (size) (5) screen _____ (length) (depth to top) (size) (material) (6) pump <u>1</u> <u>100 gpm</u> (HP) (yield gpm) (type power) (7) electric log _____ (yes or no) (organization running log) (8) how well bottom plugged <u>open</u>	shale	8.5	105
	sandy sha.	105	170
	shale	170	200
	sand	200	380
	sandy shale	380	490
	shale	490	461
	Rock & shells	461	490
	open sand & sandy shale	490	520
DRILLERS REMARKS:			


DEPT. OF NATURAL RESOURCES
BUREAU OF LAND & WATER RESOURCES

AUG 18 1980

RECEIVED

If well telescopes please sketch and show depths.

GROUND LEVEL

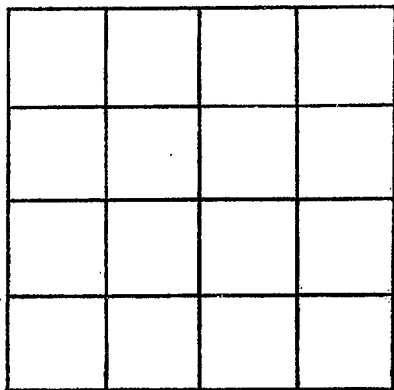

SECTION _____

Please indicate well location X.

ADDITIONAL INFORMATION

If more than one screen,
show locations of each on sketch.