

NEWTON
J 2023
10-80

MISSISSIPPI
 BOARD OF WATER COMMISSIONERS
 416 North State Street
 Jackson, Mississippi 39201

WATER WELL DRILLERS LOG

10 - 19 80 date well completed Wilkinson Drilling Newton firm name Wilkinson Drilling county well located

LANDOWNER: HARMON Crosby
RT 1 Box 63 B
LAWRENCE MISS
 (mailing address)

description of formations encountered	from	to
<u>yellow clay</u>	<u>0</u>	<u>20</u>
<u>sand/clay</u>	<u>20</u>	<u>30</u>
<u>sand</u>	<u>30</u>	<u>50</u>

WELL LOCATION:
 sec. 4 T. 6 (N) R. 10 (E)
4 miles NE of LAKE
 (distance) (direction) (nearest town)

WELL PURPOSE: home
 (home, irrigation, municipal, industrial)

- WELL COMPLETION DATA:
- (1) diameter (inches) 2"
 - (2) total depth (feet) 50
 - (3) static water level (feet) 20 below above top of ground.
 - (4) casing PVC, 40
 (material) (depth)
 (size) if telescope see back.
 - (5) screen 10', 50
 (length) (depth to top)
2, S. Steel
 (size) (material)
 - (6) pump 3/4, 7
 (HP) (yield gpm)
Elec
 (type power)
 - (7) electric log NO
 (yes or no)
 (organization running log)
 - (8) how well bottom plugged 2" BWU

DEPT. OF NATURAL RESOURCES
 BUREAU OF LAND & WATER RESOURCES


OCT 16 1980

RECEIVED

DRILLERS REMARKS:

If well telescopes please sketch and show depths.

GROUND LEVEL

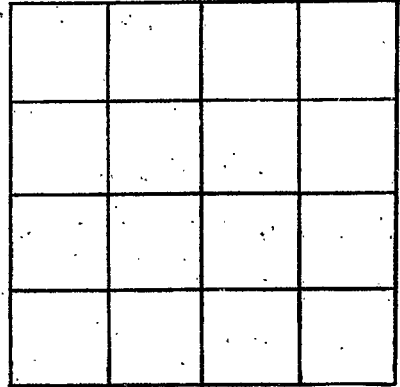

SECTION _____

Please indicate well location X.

ADDITIONAL INFORMATION

If more than one screen, show locations of each on sketch.