

MISSISSIPPI DEPARTMENT OF NATURAL RESOURCES

Bureau of Land and Water Resources

Southport Mall

P.O. Box 10631

Jackson, Mississippi 39209

WATER WELL DRILLERS LOG

NEWTON  
J 2025  
4-2-81

4-2-81

McDonald Well Newton

date well completed

firm name

county well located

LANDOWNER:

Grady Leach  
Rt # 1 Lawrence  
(mailing address)

description of formations encountered

clay  
sand

from

to

0 15  
15 90

WELL LOCATION:

sec. 2 T 6 N R 10 E  
S 5 miles N of Lawrence  
(distance) (direction) (nearest town)

WELL PURPOSE:

home  
(home, irrigation, municipal, industrial)

WELL COMPLETION DATA:

- (1) diameter (inches) 2"
- (2) total depth (feet) 90'
- (3) static water level (feet) 30' below top of ground.
- (4) casing PVC 45'  
(material) (depth)  
2' (size) If telescope see back.
- (5) screen 5' 45' to 90'  
(length) (depth to top)  
2" (size) PVC (material)
- (6) pump 1/2 49.0 M  
(HP) (y/d/gpm)  
E (type power)
- (7) electric log (yes or no)
- (organization running log)
- (8) how well bottom plugged

DEPT. OF NATURAL RESOURCES  
BUREAU OF LAND & WATER RESOURCES


APR - 6 1981

RECEIVED

DRILLERS REMARKS:

If well telescopes please  
sketch and show depths.

GROUND LEVEL

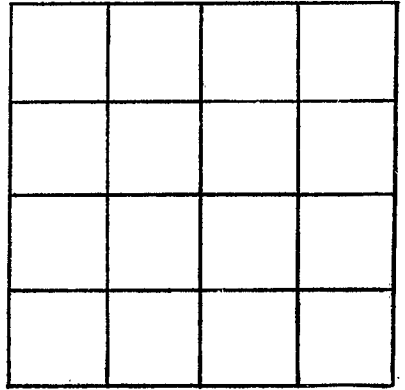

SECTION \_\_\_\_\_

Please indicate well location X.

ADDITIONAL INFORMATION

If more than one screen,  
show locations of each on sketch.