

NEWTON
J 2028
4/24/81

MISSISSIPPI
BOARD OF WATER COMMISSIONERS
416 North State Street
Jackson, Mississippi 39201

WATER WELL DRILLERS LOG

1981 WILKERSON DRILLING NEWTON
date well completed firm name county well located

LANDOWNER: HERMAN KELLY

DA REMISS
(mailing address)

WELL LOCATION:
sec 118 T 6 N R 10 E
S W
2 1/2 miles NORTH of LAKE
(distance) (direction) (nearest town)

WELL PURPOSE: HOME
(home, irrigation, municipal, industrial)

WELL COMPLETION DATA:

- (1) diameter (inches) 2 1/2
- (2) total depth (feet) 168
- (3) static water level (feet) 60' below top of ground.
- (4) casing 2 1/2" 158'
(material) (depth)
- (size) If telescope see back.
- (5) screen 10' 158'
(length) (depth to top)
- 24 PLASTIC
(size) (material)
- (6) pump 2 15
(HP) (yield gpm)
- ELEC
(type power)
- (7) electric log NO
(yes or no)

(organization running log)

(8) how well bottom plugged CAP

description of formations encountered	from	to
Red CLAY	0	38
SAND + SILT	38	98
BROWN CLAY + SAND	95	150
WATER SAND	100	168

DEPT. OF NATURAL RESOURCES
BUREAU OF LAND & WATER RESOURCES


MAY 18 1981

DRILLERS REMARKS:

RECEIVED

If well telescopes please sketch and show depths.

GROUND LEVEL:

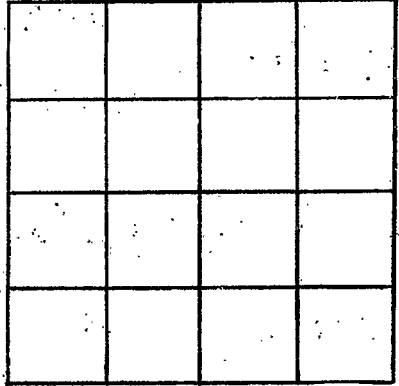

SECTION _____

Please indicate well location X.

ADDITIONAL INFORMATION

If more than one screen, show locations of each on sketch.