

MISSISSIPPI DEPARTMENT OF NATURAL RESOURCES

Bureau of Land and Water Resources

Southport Mall

P.O. Box 10631

Jackson, Mississippi 39209

WATER WELL DRILLERS LOG

NEWTON
J 2029
9-2-81

9-2-81
 date well completed

McDonald & Hill
 firm name

Newton
 county well located

LANDOWNER:	description of formations encountered	from	to
James Mayo Rt # 1 Lawrence (mailing address)			
WELL LOCATION: sec. 14 T-6N R-10E 1/2 miles N of Lawrence (distance) (direction) (nearest town)	sandy shale	15	60
WELL PURPOSE: home (home, irrigation, municipal, industrial)	shale	60	80
WELL COMPLETION DATA: (1) diameter (inches) 4" (2) total depth (feet) 480' (3) static water level (feet) 135' below top of ground. (4) casing PVC HDD' (material) (depth) 4" (size) if telescope see back. (5) screen (length) (depth to top) (size) (material) (6) pump 3/4 89 P.M. (HP) (y/eld gpm) (type power) (7) electric log (yes or no) (organization running log) (8) how well bottom plugged Open	shale & st sand	80	150
	sand	150	230
	sandy shale	230	340
	shale	340	385
	Rock & shells	385	425
	green sand & sand shale	425	455
		455	480

DEPT OF NATURAL RESOURCES
 BUREAU OF LAND & WATER RESOURCES



SEP - 8 1981

RECEIVED

DRILLERS REMARKS:

If well telescopes please sketch and show depths.

GROUND LEVEL

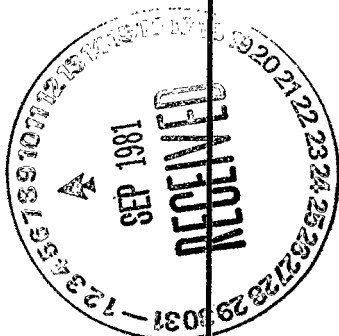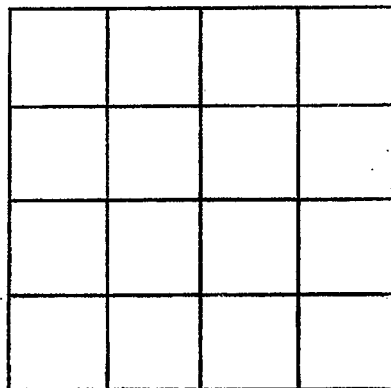

SECTION _____

Please indicate well location X.

ADDITIONAL INFORMATION

If more than one screen, show locations of each on sketch.