

Newton
J
2031

MISSISSIPPI
BOARD OF WATER COMMISSIONERS
416 North State Street
Jackson, Mississippi 39201

WATER WELL DRILLERS LOG

Sept. 11 1981 Leil Kearsaw Drilling Newton
date well completed firm name county well located

LANDOWNER: Martin Nelson

Sawarmel miss
(mailing address)

description of formations encountered	from	to
<u>yellow clay sand</u>	<u>0</u>	<u>20</u>
<u>Blue clay sand</u>	<u>20</u>	<u>75</u>
<u>SANDSHALE</u>	<u>75</u>	<u>283</u>

WELL LOCATION:
sec. 12 T. 6 N R. 10 E
S W
4 miles North of Lawrence
(distance) (direction) (nearest town)

WELL PURPOSE: home
(home, irrigation, municipal, industrial)

- WELL COMPLETION DATA:
- (1) diameter (inches) 2"
 - (2) total depth (feet) 283'
 - (3) static water level (feet) 50' below above top of ground.
 - (4) casing PVC, 273'
(material) (depth)
(size) If telescope see back.
 - (5) screen 10, 283'
(length) (depth to top)
2, PVC
(size) (material)
 - (6) pump 3, 8
(HP) (yield gpm)
51cc
(type power)
 - (7) electric log No
(yes or no)
(organization running log)
 - (8) how well bottom plugged _____

DRILLERS REMARKS:


DEPT. OF NATURAL RESOURCES
BUREAU OF LAND & WATER RESOURCES

JAN 11 1982

RECEIVED

If well telescopes please sketch and show depths.

GROUND LEVEL

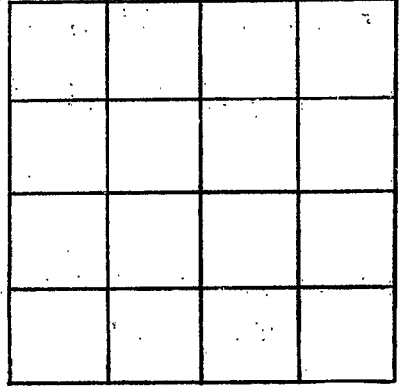

SECTION _____

Please indicate well location X.

ADDITIONAL INFORMATION

If more than one screen, show locations of each on sketch.