

Newport  
 232

MISSISSIPPI  
 BOARD OF WATER COMMISSIONERS  
 416 North State Street  
 Jackson, Mississippi 39201

WATER WELL DRILLERS LOG

Sept 1981 date well completed  
 Wilkerson Drilling firm name  
 Newton county well located

LANDOWNER: <u>Wilkerson Drilling</u>	description of formations encountered	from	to
<u>Lawrence Miss</u> (mailing address)	<u>yellow clay</u> <u>Broken clay + sand</u> <u>SAND</u>	<u>0</u> <u>20</u> <u>80</u>	<u>20</u> <u>80</u> <u>150</u>
<b>WELL LOCATION:</b>			
sec. <u>12</u> T. <u>6</u> N R. <u>10</u> E S W <u>4</u> miles <u>North</u> of <u>Lake</u> (distance) (direction) (nearest town)			
<b>WELL PURPOSE:</b> <u>home</u> (home, irrigation, municipal, industrial)			
<b>WELL COMPLETION DATA:</b>			
(1) diameter (inches) <u>2'</u>			
(2) total depth (feet) <u>150'</u>			
(3) static water level (feet) <u>30</u> <u>below</u> top of ground.			
(4) casing <u>PVC</u> , <u>150</u> (material) (depth)			
_____ if telescope see back. (size)			
(5) screen <u>10</u> , <u>PVC</u> (length) (depth to top)			
<u>2"</u> , <u>PVC</u> (size) (material)			
(6) pump <u>1hp</u> , <u>7</u> (HP) (yield gpm)			
<u>elec</u> (type power)			
(7) electric log <u>No</u> (yes or no)			
_____ (organization running log)			
(8) how well bottom plugged _____			
<b>DRILLERS REMARKS:</b> _____			


DEPT. OF NATURAL RESOURCES  
 BUREAU OF LAND & WATER RESOURCES

JAN 11 1982

RECEIVED

If well telescopes please  
sketch and show depths.

GROUND LEVEL

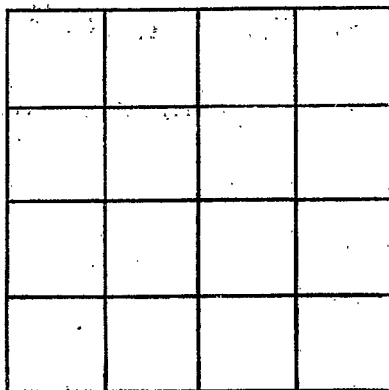

SECTION \_\_\_\_\_

Please indicate well location X.

ADDITIONAL INFORMATION

If more than one screen,  
show locations of each on sketch.