

MISSISSIPPI DEPARTMENT OF NATURAL RESOURCES

Bureau of Land and Water Resources

Southport Mall

P.O. Box 10631

Jackson, Mississippi 39209

WATER WELL DRILLERS LOG

Newton
82034

9-28-82 19 McDonald & Hill Newton
date well completed firm name county well located

LANDOWNER:
Mark & Bonnie Anderson
RT# 1, Box 62A, Decatur
(mailing address)

WELL LOCATION:
sec. 13 T 6 N R. 10 E
8 miles NW of Newton
(distance) (direction) (nearest town)

WELL PURPOSE: home
(home, irrigation, municipal, industrial)

WELL COMPLETION DATA:

- (1) diameter (inches) 4"
- (2) total depth (feet) 480'
- (3) static water level (feet) _____ below above top of ground.
- (4) casing PVC 400'
(material) (depth)
4" if telescope see back.
(size)
- (5) screen _____
(length) (depth to top)
(size)
- (6) pump 3 1/2 89 gpm
(HP) (yield gpm)
F
(type power)
- (7) electric log _____
(yes or no)
(organization running log)
- (8) how well bottom plugged open

description of formations encountered	from	to
clay	0	10
sand	10	60
sand & shale & clay	60	90
shale	90	110
sandy shale & rock	110	170
sand	170	190
shale & sand	190	240
sand	240	350
sandy shale	350	400
shale	400	426
Rock & shell	426	455
green sand	455	480

DEPT. OF NATURAL RESOURCES
BUREAU OF LAND & WATER RESOURCES


OCT - 4 1982

RECEIVED

DRILLERS REMARKS: _____

If well telescopes please sketch and show depths.

GROUND LEVEL

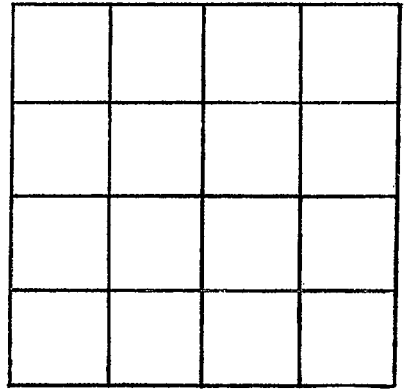

SECTION _____

Please indicate well location X.

ADDITIONAL INFORMATION

If more than one screen,
show locations of each on sketch.