

Newton  
J  
2036

MISSISSIPPI  
BOARD OF WATER COMMISSIONERS  
416 North State Street  
Jackson, Mississippi 39201

WATER WELL DRILLERS LOG

Feb 10 1984 Wilkinson Drilling Newton  
date well completed firm name county well located

LANDOWNER:  
George E Clark  
Star Rt. Box 39 Lake, Miss  
(mailing address)

WELL LOCATION:  
sec. 5 T. 6N R. 10E  
S W  
3.5 miles North of Lake  
(distance) (direction) (nearest town)

WELL PURPOSE: Home  
(home, irrigation, municipal, industrial)

- WELL COMPLETION DATA: 2.10-84
- (1) diameter (inches) 2"
  - (2) total depth (feet) 97
  - (3) static water level (feet) 50 below top of ground.
  - (4) casing SCH 40 (material) 97 (depth)  
2 (size) if telescope see back.
  - (5) screen 10' (length) (depth to top)  
2" (size) SCH 40 (material)
  - (6) pump air (HP) 9 (yield gpm)  
ELC (type power)
  - (7) electric log no (yes or no)  
(organization running log)
  - (8) how well bottom plugged CUP


description of formations encountered	from	to
Red clay	0	10
" "	10	20
" "	20	30
PINK SAND	30	40
YELLOW SAND	40	50
MIXED SAND	50	60
" "	60	70
White SAND	70	80
CORSE WHITE SAND	80	90
" "	90	100

DRILLERS REMARKS:

APR - 2 1984  
RECEIVED

If well telescopes please sketch and show depths.

GROUND LEVEL

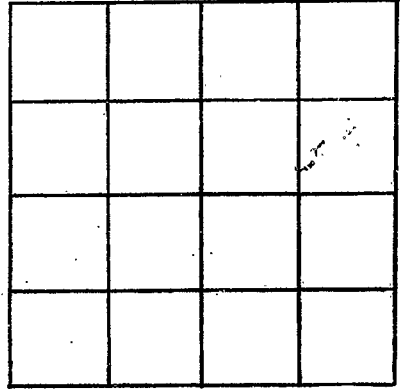

SECTION \_\_\_\_\_

Please indicate well location X.

ADDITIONAL INFORMATION

If more than one screen, show locations of each on sketch.