

MISSISSIPPI DEPARTMENT OF NATURAL RESOURCES

Bureau of Land and Water Resources

Southport Mall

P.O. Box 10631

Jackson, Mississippi 39209

WATER WELL DRILLERS LOG

Newton
8
2037

4-27-84
date well completed

McDonalds Well
firm name

Newton
county well located

LANDOWNER:	description of formations encountered	from	to
Randy Davis			
Rt # 1 Lawrence (mailing address)	sand & clay	10	65
WELL LOCATION:	shale	65	100
sec. <u>14</u> T. <u>6</u> N. R. <u>10</u> E S W	sandy shale	100	180
<u>4</u> miles N of Lawrence (distance) (direction) (nearest town)	shale & st sand	180	260
WELL PURPOSE: <u>home</u> (home, irrigation, municipal, industrial)	sand	260	345
WELL COMPLETION DATA:	sandy shale	345	385
(1) diameter (inches) <u>4"</u>	shale	385	439
(2) total depth (feet) <u>500'</u>	Rock & shells	439	470
(3) static water level (feet) <u>165'</u> below top of ground	green sand	470	500
(4) casing <u>PVC 4/10</u> (material) (depth) <u>4"</u> (size) If telescope see back.			
(5) screen (length) (depth to top) (size) (material)			
(6) pump <u>1</u> <u>890 PM</u> (HP) (yield gpm) <u>F</u> (type power)			
(7) electric log <u>yes</u> (yes or no) (organization running log)			
(8) how well bottom plugged <u>open</u>			
DRILLERS REMARKS:			


DEPT. OF NATURAL RESOURCES
BUREAU OF LAND & WATER RESOURCES

MAY -7 1984

RECEIVED

If well telescopes please
sketch and show depths.

GROUND LEVEL

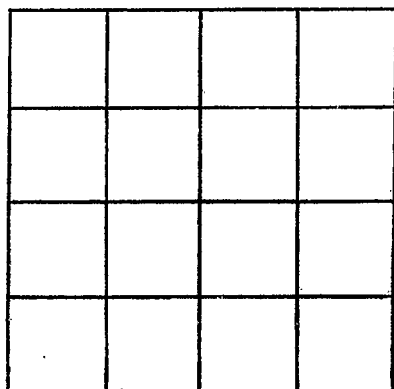

SECTION _____

Please indicate well location X.

ADDITIONAL INFORMATION

If more than one screen,
show locations of each on sketch.