

MISSISSIPPI DEPARTMENT OF NATURAL RESOURCES

Bureau of Land and Water Resources

Southport Mall

P.O. Box 10631

Jackson, Mississippi 39209

WATER WELL DRILLERS LOG

<i>Newton</i>
<i>8</i>
<i>2038</i>

6-1-84
19 McDonald Hill
Newton

date well completed
firm name
county well located

LANDOWNER:
Randall Leon Craps
RT # 1 Decatur
(mailing address)

WELL LOCATION:
 sec *1* T *6* N R *10* E
S
6 miles *N* of *Newton*
(distance) (direction) (nearest town)

WELL PURPOSE: *Home*
(home, irrigation, municipal, industrial)

WELL COMPLETION DATA:

(1) diameter (inches) *4"*

(2) total depth (feet) *460'*

(3) static water level (feet) *210'* below above top of ground.

(4) casing *PVC 390'*
(material) (depth)
4" If telescope see back.
(size)

(5) screen _____
(length) (depth to top)
(size) (material)

(6) pump *1* *90 RPM*
(HP) (y/eld gpm)
E
(type power)

(7) electric log _____
(yes or no)
(organization running log)

(8) how well bottom plugged *Open*

description of formations encountered	from	to
<i>clay</i>	<i>0</i>	<i>10</i>
<i>sand st clay</i>	<i>10</i>	<i>75</i>
<i>shale</i>	<i>75</i>	<i>95</i>
<i>sandy shale</i>	<i>95</i>	<i>150</i>
<i>shale st sand</i>	<i>150</i>	<i>260</i>
<i>sand</i>	<i>260</i>	<i>330</i>
<i>sandy shale</i>	<i>330</i>	<i>370</i>
<i>shale</i>	<i>370</i>	<i>410</i>
<i>Rocky shale</i>	<i>410</i>	<i>440</i>
<i>green sand & sandy shale</i>	<i>440</i>	<i>460</i>

DRILLERS REMARKS:


RECEIVED

JUN 11 1984

DEPT. OF NATURAL RESOURCES
BUREAU OF LAND & WATER RESOURCES

If well telescopes please sketch and show depths.

GROUND LEVEL

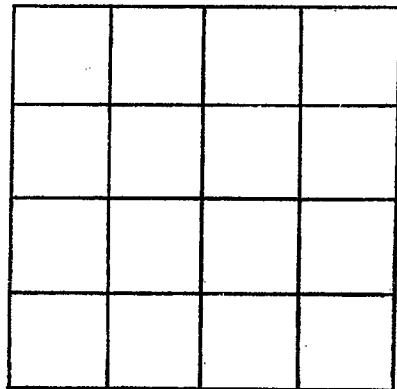

SECTION _____

Please indicate well location X.

ADDITIONAL INFORMATION

If more than one screen,
show locations of each on sketch.