

MISSISSIPPI DEPARTMENT OF NATURAL RESOURCES

Bureau of Land and Water Resources

Southport Mall

P.O. Box 10631

Jackson, Mississippi 39209

WATER WELL DRILLERS LOG

NEWTON
J 239

7-17-84
date well completed

McDonald's Well
firm name

Newton
county well located

LANDOWNER:
Sarah D. Tomper
Rt # 1 Lawrence
(mailing address)

description of formations encountered	from	to
sandy clay	0	20
shale	20	75

WELL LOCATION:
sec. 2 T. 6N R. 10E
S S W
5 miles SE of Coahoma
(distance) (direction) (nearest town)

sandy shale	75	125
shale st sand	125	200
sand	200	240

WELL PURPOSE: home
(home, irrigation, municipal, industrial)

shale	240	260
-------	-----	-----

WELL COMPLETION DATA:

- (1) diameter (inches) 4
- (2) total depth (feet) 440'
- (3) static water level (feet) 140' below top of ground.
- (4) casing PVC, 360' (material) (depth)
4" (size) if telescope see back.
- (5) screen (length) (depth to top)
(size) (material)
- (6) pump 3/4 (HP) 9000 (type power) (gpm)
- (7) electric log (yes or no)
(organization running log)
- (8) how well bottom plugged Dopey

sand	260	285
sandy shale	285	330
shale	330	380
rock & shells	380	410
green sandy shale	410	440

MISSISSIPPI DEPT. OF NATURAL RESOURCES
BUREAU OF LAND & WATER RESOURCES


JUL 23 1984

RECEIVED

DRILLERS REMARKS:

If well telescopes please
sketch and show depths.

GROUND LEVEL

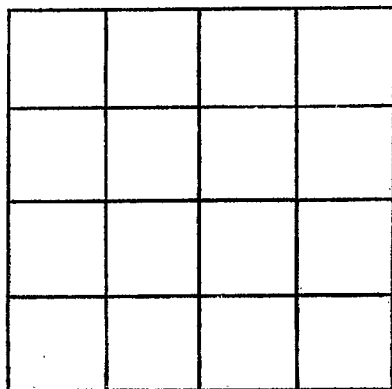

SECTION _____

Please indicate well location X.

ADDITIONAL INFORMATION

If more than one screen,
show locations of each on sketch.