

MISSISSIPPI DEPARTMENT OF NATURAL RESOURCES

Bureau of Land and Water Resources

Southport Mall

P.O. Box 10631

Jackson, Mississippi 39209

WATER WELL DRILLERS LOG

Newton
J
2040

10-8-84
date well completed

McDonald & Hill
firm name

Newton
county well located

LANDOWNER:
Billy Haskell Davis
Rt #1 Decatur
(mailing address)

WELL LOCATION:
sec. 1 T. 6 N. R. 10 E
S W
1.8 miles NW of Newton
(distance) (direction) (nearest town)

WELL PURPOSE: home
(home, irrigation, municipal, industrial)

WELL COMPLETION DATA:

(1) diameter (inches) 4"

(2) total depth (feet) 460'

(3) static water level (feet) 160' below top of ground.

(4) casing PVC 380'
(material) (depth)
4" if telescope see back.
(size)

(5) screen
(length) (depth to top)
(size) (material)

(6) pump 3W 290M
(HP) (yield gpm)

(7) electric log E
(yes or no)
(organization running log)

(8) how well bottom plugged OPEN

description of formations encountered	from	to
clay st sand	0	40
shale	40	80
sandy shale	80	140
shale & sand	140	240
sand	240	330
sandy shale	330	360
shale	360	400
rock & shells	400	430
green sand & sandy shale	430	460


DEPT. OF NATURAL RESOURCES
BUREAU OF LAND & WATER RESOURCES

OCT 11 1984
RECEIVED

DRILLERS REMARKS:
set pump 500'

If well telescopes please sketch and show depths.

GROUND LEVEL

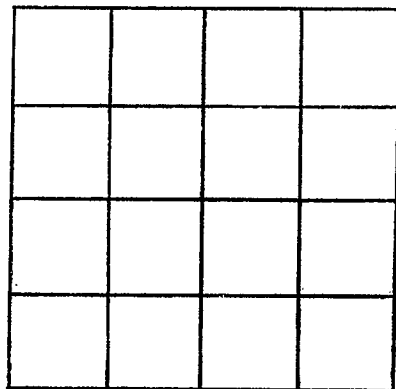

SECTION _____

Please indicate well location X.

ADDITIONAL INFORMATION

If more than one screen,
show locations of each on sketch.