

**MISSISSIPPI DEPARTMENT OF NATURAL RESOURCES**

Bureau of Land and Water Resources

Southport Mall

P.O. Box 10631

Jackson, Mississippi 39209

**WATER WELL DRILLERS LOG**

**NEWTON**  
J 2041

5/27/19 date well completed      86 Jerry Drilling Co. firm name      Newton county well located

**LANDOWNER:**  
Bobby Boy  
RT1 Lawrence, Miss.  
(mailing address)

description of formations encountered	from	to
	<u>yellow clay</u>	<u>0</u>
<u>yellow sand</u>	<u>25</u>	<u>60</u>
<u>clay</u>	<u>60</u>	<u>140</u>
<u>sand</u>	<u>140</u>	<u>160</u>

**WELL LOCATION:**  
sec. 29 T. 6 N. R. 10 E.  
3 miles W of Lawrence  
(distance) (direction) (nearest town)

**WELL PURPOSE:**  
(home, irrigation, municipal, industrial)

**WELL COMPLETION DATA:**

(1) diameter (inches) 2"

(2) total depth (feet) 160

(3) static water level (feet) 80 <sup>below</sup>/<sub>above</sub> top of ground.

(4) casing PVC, 150  
(material) (depth)

\_\_\_\_ if telescope see back.  
(size)

(5) screen 10' , 150  
(length) (depth to top)

2" PVC  
(size) (material)


(6) pump 1 5  
(HP) (yield gpm)

jet  
(type power)

(7) electric log \_\_\_\_\_  
(yes or no)

\_\_\_\_\_  
(organization running log)

(8) how well bottom plugged wash valve

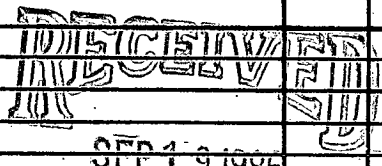


**SEP 19 1986**

**DRILLERS REMARKS:**  
\_\_\_\_\_  
\_\_\_\_\_

Department of Natural Resources  
Bureau of Land & Water Resources

If well telescopes please  
sketch and show depths.

GROUND LEVEL

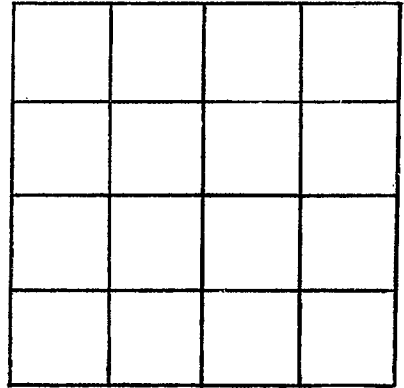

SECTION \_\_\_\_\_

Please indicate well location X.

ADDITIONAL INFORMATION

If more than one screen,  
show locations of each on sketch.