

MISSISSIPPI DEPARTMENT OF NATURAL RESOURCES

Bureau of Land and Water Resources

Southport Mall

P.O. Box 10631

Jackson, Mississippi 39209

WATER WELL DRILLERS LOG

NEWTON  
J2042

8/18/86  
date well completed

6 Jerry Drilling Co  
firm name

Newton  
county well located

LANDOWNER:  
Mary Lofton  
Rt 1 Laurence Min  
(mailing address)

description of formations encountered	from	to
<u>yellow clay</u>	<u>0</u>	<u>15</u>
<u>sand</u>	<u>15</u>	<u>20</u>
<u>clay &amp; hockey</u>	<u>20</u>	<u>200</u>
<u>clay</u>	<u>200</u>	<u>300</u>
<u>rocky &amp; clay</u>	<u>300</u>	<u>350</u>
<u>sandy &amp; clay</u>	<u>350</u>	<u>480</u>

WELL LOCATION:  
sec. 1 T. 6 N. R. 10 E.  
S. W.  
9 miles NW of Newton  
(distance) (direction) (nearest town)

WELL PURPOSE:  
 home, irrigation, municipal, industrial

WELL COMPLETION DATA:

(1) diameter (inches) 4"

(2) total depth (feet) 480

(3) static water level (feet) 180 below/above top of ground.

(4) casing PVC, 300,  
(material) (depth)

\_\_\_\_\_ If telescope see back.  
(size)

(5) screen \_\_\_\_\_,  
(length) (depth to top)

\_\_\_\_\_ (size) \_\_\_\_\_ (material)

(6) pump 3/4 6-8  
(HP) (yield gpm)

\_\_\_\_\_ (type power)

(7) electric log \_\_\_\_\_  
(yes or no)

\_\_\_\_\_ (organization running log)

(8) how well bottom plugged Open


RECEIVED  
SEP 19 1986

Department of Natural Resources  
Bureau of Land & Water Resources

DRILLERS REMARKS:

If well telescopes please  
sketch and show depths.

GROUND LEVEL

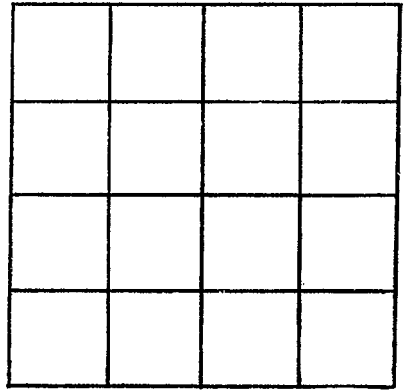

SECTION \_\_\_\_\_

Please indicate well location X.

ADDITIONAL INFORMATION

If more than one screen,  
show locations of each on sketch.