

K3

K 300

WATER WELL DRILLERS LOG

7-23-60

Date: 7-23, 1960, Driller: W. L. Welch County Newton

(Name)

(1) Owner of Land: CH Lancaster  
(Name)  
Laurence Miss  
(Address)

(2) Location: SW 1/4, SE 1/4, Sec. 30 T6 R11  
2 miles West, of Newton  
(distance) (direction) (Nearest Town)

(3) Topography:  (Hilly)  (Flat)  (Level)

(4) Purpose of Well: Domestic  
(Domestic Irrigation  
 Municipal, Industrial, Other)

Description & Color of Materials Sand, Clay, Red Clay, Shell, etc.	Thick- ness Feet	Depth Feet
<u>Red clay</u>	<u>21</u>	<u>0-32</u>
<u>Brown clay</u>	<u>21</u>	<u>22-43</u>
<u>Pink sand</u>	<u>22</u>	<u>43-65</u>
<u>White sand</u>	<u>31</u>	<u>65-96</u>


Information upon completion of well:

- (1) Diameter 2" inches.
- (2) Total Depth 96 feet.
- (3) Water Level 25 feet below top of ground.
- (4) Cased to 96, Size 2"
- (5) Screen: Size 70 Size 11' Length 11'
- (6) Were any formations sealed against pollution?  
 \_\_\_\_\_ yes,  no.

If YES depth of formation \_\_\_\_\_

Why \_\_\_\_\_

Drillers Remarks: \_\_\_\_\_

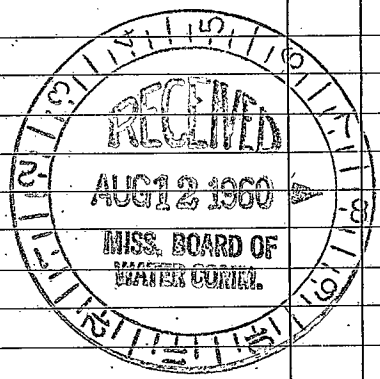

(Use Back Side)

