

3

K301

K5

WATER WELL DRILLERS LOG

9-27-60

Date: 9-27, 1960, Driller: Y. L. Welch County Newton

DENSON

(Name)

(1) Owner of Land: J. M. Jelder (Name)

Newton Miss (Address)

(2) Location: SE 1/4, SE 1/4, Sec. 21, T6 R11

1 miles N. of Newton (distance) (direction) (Nearest Town)

(3) Topography: (Hilly) (Flat) (Level)

(4) Purpose of Well: Domestic (Domestic Irrigation Municipal, Industrial, Other)

Information upon completion of well:


- (1) Diameter 2 inches.
(2) Total Depth 244 feet.
(3) Water Level 56 feet below top of ground.
(4) Cased to 244, Size 2"
(5) Screen: Size #70, Length 10'
(6) Were any formations sealed against pollution? yes, no.

If YES depth of formation

Why

Drillers Remarks:

Table with 3 columns: Description & Color of Materials, Thickness Feet, Depth Feet. Rows include R Clay, Blue, Shell, Blue Sandy, Sand.

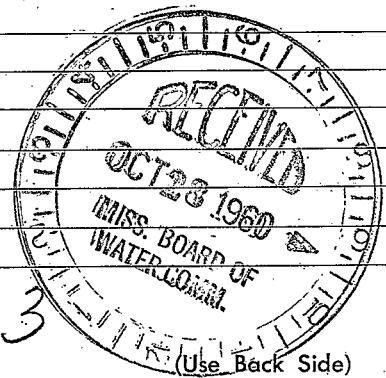

Well No.

*[Faint, illegible handwritten text, possibly bleed-through from the reverse side of the page.]*