

3 NEWTON  
K 6

K 302<sup>p</sup>

**WATER WELL DRILLERS LOG**

1-16-61

Date: 1-16, 1961, Driller: W. L. Sheld County Newton  
(Name)

- (1) Owner of Land: E. H. Williams  
(Name)  
Newton Miss  
(Address)
- (2) Location: W 1/4 NW 1/4, Sec 32, T 6 R 11 E  
1 miles West of Newton  
(distance) (direction) (Nearest Town)
- (3) Topography:  (Hilly)  (Flat)  (Level)
- (4) Purpose of Well: Domestic  
(Domestic Irrigation, Municipal, Industrial, Other)

Description & Color of Materials  
Sand, Clay, Red Clay, Shell, etc.


Thick-ness Feet

Depth Feet

<u>Clay Brown</u>	10	0-10
<u>Sand W.</u>	40	10-50

**Information upon completion of well:**

- (1) Diameter 2 inches.
- (2) Total Depth 50 feet.
- (3) Water Level 2 feet below top of ground.
- (4) Cased to 50, Size 2"
- (5) Screen: Size 20, Length 6'
- (6) Were any formations sealed against pollution?  
no.

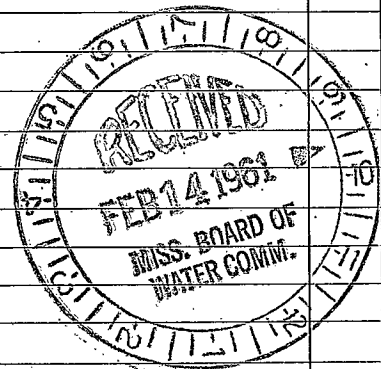

If YES depth of formation \_\_\_\_\_

Why \_\_\_\_\_

Drillers Remarks: \_\_\_\_\_

12

Well No.

(Use Back Side)

