

WATER WELL DRILLERS LOG

12-12-61

Date: 12-12, 1961, Driller: U. L. Shelch County Newton

(Name)

(1) Owner of Land: Raymond Sanderson  
Newton Miss  
(Name)  
(Address)

Description & Color of Materials  
Sand, Clay, Red Clay, Shell, etc.

Thick-  
ness  
Feet

Depth  
Feet

Clay  
Sand

10 0-10  
60 10-70

(2) Location: NW 1/4, NE 1/4, Sec 20 T6R11,  
3 1/2 miles NW of Newton  
(distance) (direction) (Nearest Town)

(3) Topography:  (Hilly)  (Flat)  (Level)

(4) Purpose of Well: Domestic  
(Domestic Irrigation  
Municipal, Industrial, Other)

Information upon completion of well:

(1) Diameter 2" inches.

(2) Total Depth 70 feet.

(3) Water Level 49 feet below top of ground.

(4) Cased to 70, Size 2"


(5) Screen: Size #8 slot, Length 6'

(6) Were any formations sealed against pollution?  
yes,  no.

If YES depth of formation

Why

Drillers Remarks:

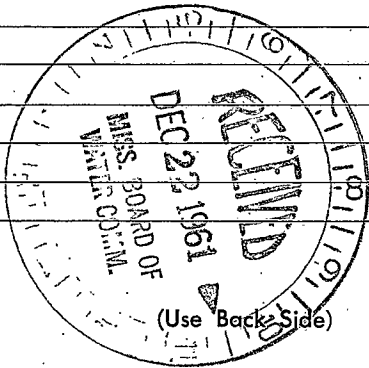

21

Well No.

