

NEWTON

K11

5-29-62

WATER WELL DRILLERS LOG

Date: 5-29, 1962, Driller: W. L. Welch County Newton

(Name)

(1) Owner of Land: S. L. Bounds
(Name)
Newton Miss
(Address)

Description & Color of Materials
Sand, Clay, Red Clay, Shell, etc.

Thick-
ness
Feet

Depth
Feet

Clay 20 0-20
Sand 55 20-75

(2) Location: NW 1/4, NE 1/4, Sec. 20 T6R11,
4 miles N West, of Newton
(distance) (direction) (Nearest Town)

(3) Topography: (Level)
(Hilly) (Flat)

(4) Purpose of Well: Domestic
(Domestic Irrigation
Municipal, Industrial, Other)

Information upon completion of well:

(1) Diameter 2 1/2 inches.

(2) Total Depth 75 feet.

(3) Water Level 45 feet below top of ground.

(4) Cased to 75, Size 3"


(5) Screen: Size 70 mesh, Length 6'

(6) Were any formations sealed against pollution?
no, yes.

If YES depth of formation _____

Why _____

Drillers Remarks: _____

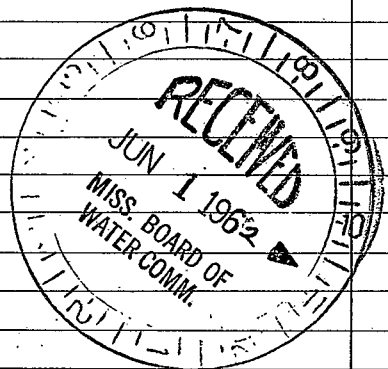

37

Well No.

(Use Back Side)

