

3
NEWTON

K 17

WATER WELL DRILLERS LOG

12-7-62

Date: Dec 7, 1962, Driller: H. L. Sheld County, Newton
(Name)

(1) Owner of Land: <u>J. H. Valentine</u> (Name) <u>Newton Miss</u> (Address)	Description & Color of Materials Sand, Clay, Red Clay, Shell, etc. Clay Blue Bone & Shell Sand	Thick-ness Feet 16 27 42 22	Depth Feet 0-16 16-43 43-85 85-103
(2) Location: <u>NE 1/4, NE 1/4, Sec. 28 T6 R11</u> <u>1</u> miles <u>N.W.</u> of <u>Newton</u> (distance) (direction) (Nearest Town)			
(3) Topography: <input checked="" type="checkbox"/> (Hilly) <input type="checkbox"/> (Flat) <input type="checkbox"/> (Level)			
(4) Purpose of Well: <u>Domestic</u> (Domestic Irrigation Municipal, Industrial, Other)			


Information upon completion of well:

- (1) Diameter 2" inches.
- (2) Total Depth 107 feet.
- (3) Water Level 52 feet below top of ground.
- (4) Cased to 77, Size 2"
- (5) Screen: Size None, Length None
- (6) Were any formations sealed against pollution?
 yes, no.

If YES depth of formation _____

Why _____

Drillers Remarks: _____

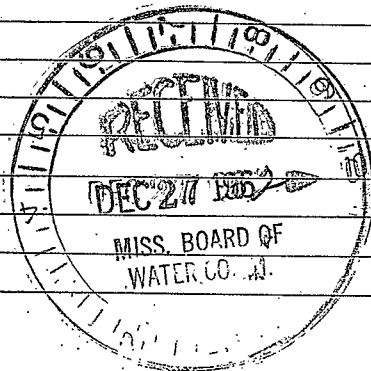

(Use Back Side)

55

Well No.

[The page contains extremely faint and illegible text, likely bleed-through from the reverse side of the document. The text is too light to transcribe accurately.]