

# WATER WELL DRILLERS LOG

(1) Owner of Land: Miley M. Miller  
(Name)  
Newton Miss  
(Address)

(2) Location: 1/4, 1/4, Sec. 12 <sup>6W</sup> T R11E  
5 miles N.E. of Newton  
(distance) (direction) (Nearest Town)

(3) Topography: \_\_\_\_\_  
(Hilly) (Flat) (Level)

(4) Purpose of Well: Domestic  
(Domestic Irrigation Municipal, Industrial, Other)

Description & Color of Materials Sand, Clay, Red Clay, Shell, etc.	Thick- ness Feet	Depth Feet
Red Clay		20
Blue med- cavity		35
Sand & Rock		5
Water Sand		130
		30

**Information upon completion of well:**

(1) Diameter 2 inches.

(2) Total Depth 220 feet.

(3) Water Level 80 feet below top of ground.

(4) Cased to 220, Size 2


(5) Screen: Size 2", Length 10 ft

(6) Were any formations sealed against pollution?  
 \_\_\_\_\_ yes, K no.

If YES depth of formation \_\_\_\_\_

Why \_\_\_\_\_

Drillers Remarks: \_\_\_\_\_

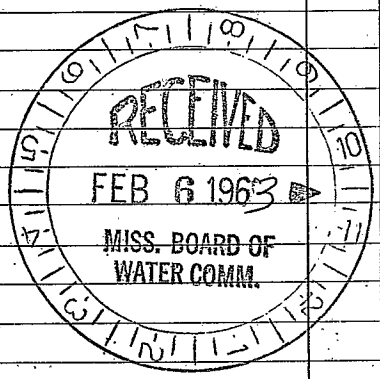

(Use Back Side)

BOARD OF