

K 25

8-11-64

WATER WELL DRILLERS LOG

Date: 8-11, 1964, Driller: J. L. Welch County Newton  
 (Name)

(1) Owner of Land: W. Everett  
 (Name)  
Newton Miss  
 (Address)

(2) Location: SE 1/4, SE 1/4, Sec. 5 T. 6 R. 11  
4 miles N of Newton  
 (distance) (direction) (Nearest Town)

(3) Topography: V  
 (Hilly) (Flat) (Level)

(4) Purpose of Well: Domestic  
 (Domestic Irrigation  
 Municipal, Industrial, Other)

Description & Color of Materials Sand, Clay, Red Clay, Shell, etc.	Thick- ness Feet	Depth Feet
Clay	12	0-12
R. sand	31	12-43
Blue	63	43-106
Blue + shell	74	106-180
Brown	31	180-211
Blue	52	211-263
Sand	53	263
		316

Information upon completion of well:

(1) Diameter 2 inches.

(2) Total Depth 316 feet.

(3) Water Level 120 feet below top of ground.


(4) Cased to 147, Size 3"

(5) Screen: Size None, Length \_\_\_\_\_

(6) Were any formations sealed against pollution?  
 \_\_\_\_\_ yes, ✓ no.

If YES depth of formation \_\_\_\_\_  
 Why \_\_\_\_\_

Drillers Remarks: \_\_\_\_\_

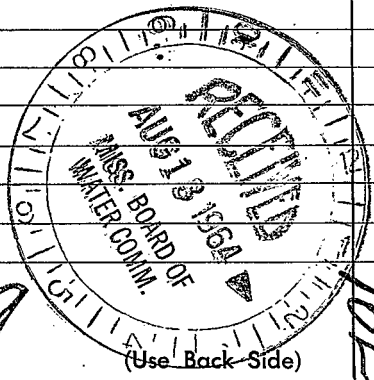

Well No. 107

