

Newton  
K 27  
7-16-72

MISSISSIPPI  
 BOARD OF WATER COMMISSIONERS  
 416 North State Street  
 Jackson, Mississippi 39201

WATER WELL DRILLERS LOG

**CODED**

7-16 1972 M. L. Welch Newton  
 date well completed firm name county well located

LANDOWNER:  
A. J. Therman  
Newton, Miss  
 (mailing address)

description of formations encountered	from	to
<u>Red Clay</u>	<u>0</u>	<u>20</u>
<u>Sand</u>	<u>20</u>	<u>47</u>

WELL LOCATION:  
 sec. 20 T. 4 N. R. 11 E.  
3 miles NW of Newton  
 (distance) (direction) (nearest town)

WELL PURPOSE: Home  
 (home, irrigation, municipal, industrial)

- WELL COMPLETION DATA:
- (1) diameter (inches) 2"
  - (2) total depth (feet) 47
  - (3) static water level (feet) 28 below top of ground
  - (4) casing Gal Steel (material) 13 (depth)  
 (size) if telescope see back.
  - (5) screen 4' (length) 47 (depth to top)  
2 5/8" (size) St. Steel (material)
  - (6) pump 1/2 (HP) 275 (yield gpm)  
 (type power)
  - (7) electric log no (yes or no)  
 (organization running log)
  - (8) how well bottom plugged

**CODED**


JUL 31 1972

MISS. BD. OF  
 WATER COMMISSIONERS

DRILLERS REMARKS:

If well telescopes please sketch and show depths.

GROUND LEVEL

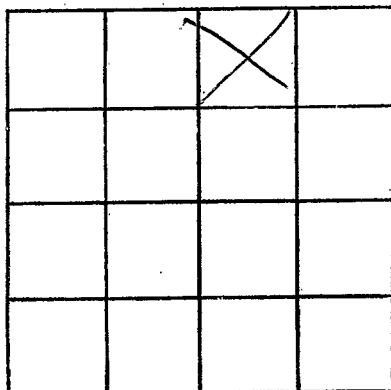

SECTION \_\_\_\_\_

Please indicate well location X.

ADDITIONAL INFORMATION

If more than one screen,  
show locations of each on sketch.