

3 K28
1-18-65

WATER WELL DRILLERS LOG

Date: 1-18, 1965, Driller: U. P. Skelton County Newton

(Name)

(1) Owner of Land: F. Atkinson
(Name)
Newton Miss
(Address)

(2) Location: NW 1/4, NW 1/4, Sec. 28 T6R14
2 miles N.E. of Newton
(distance) (direction) (Nearest Town)

(3) Topography: (Hilly) (Flat) (Level)

(4) Purpose of Well: Domestic
(Domestic Irrigation, Municipal, Industrial, Other)

Description & Color of Materials Sand, Clay, Red Clay, Shell, etc.	Thick- ness Feet	Depth Feet
<u>Yellow Clay</u>	<u>15</u>	<u>0-14</u>
<u>Sandy</u>	<u>6</u>	<u>14-20</u>
<u>Blue</u>	<u>35</u>	<u>20-25</u>
<u>Blue + Shell</u>	<u>42</u>	<u>25-117</u>
<u>Blue + Sand mix</u>	<u>53</u>	<u>117-170</u>
<u>Brown</u>	<u>77</u>	<u>170-247</u>
<u>1st Sand</u>	<u>33</u>	<u>247</u>

280

Information upon completion of well:

(1) Diameter 2" inches.

(2) Total Depth 250 feet.

(3) Water Level 70 feet below top of ground.


(4) Cased to 28, Size 2"

(5) Screen: Size 60 Hz, Length 12

(6) Were any formations sealed against pollution?
 yes, no.

If YES depth of formation _____
Why _____

Drillers Remarks: _____

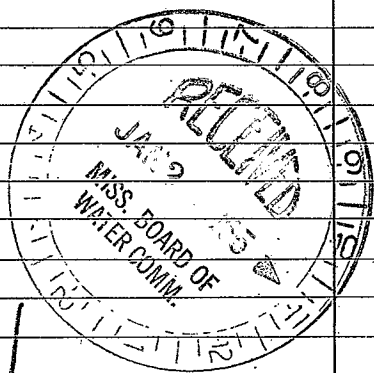

(Use Back Side)

Well No. 106

1948

1949

1950

1951