

NEWTON

MISSISSIPPI BOARD OF WATER COMMISSIONERS

K 29

WATER WELL DRILLERS LOG

6-29-65

Date: 6-29, 1965 Driller: W. L. Shalk County Newton

(Name)

(1) Owner of Land: J. P. Murphy

(Name)

Newton Miss

(Address)

(2) Location: E 1/2 E 1/4, Sec 23 T6 R14

1 miles N of Newton

(distance)

(direction)

(Nearest Town)

(3) Topography: Flat

(Hilly)

(Flat)

(Level)

(4) Purpose of Well: Domestic

(Domestic Irrigation, Municipal, Industrial, Other)

Information upon completion of well:

(1) Diameter 2 inches.

(2) Total Depth 118 feet.

(3) Water Level 30 feet below top of ground.

(4) Cased to 118, Size 2"

(5) Screen: Size 60% Length 10

(6) Were any formations sealed against pollution?

yes, no

If YES depth of formation

Why

Drillers Remarks:

Description & Color of Materials Sand, Clay, Red Clay, Shell, etc.

Thick-ness Feet

Depth Feet


Red clay 21 0-11

S. clay 21 11-32

H. sand 42 32-74

white sand 49 74-118

118

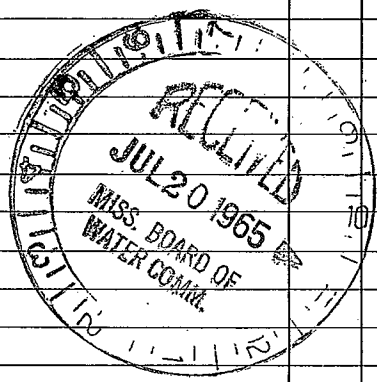

Well No. 108

(Use Back Side)

...the ... of ...

...the ... of ...

