

K 30
8-26-65

WATER WELL DRILLERS LOG

Date: 8-26, 1965, Driller: S. L. Sheld County Newton
(Name)

(1) Owner of Land: E. C. Holiday
(Name)
Newton Miss
(Address)

(2) Location: SW 1/4, SW 1/4, Sec. 22 T6 R17
1 miles N, of Newton
(distance) (direction) (Nearest Town)

(3) Topography: (Hilly) (Flat) (Level)

(4) Purpose of Well: Domestic
(Domestic Irrigation
Municipal, Industrial, Other)

Description & Color of Materials Sand, Clay, Red Clay, Shell, etc.	Thick- ness Feet	Depth Feet
<u>Clay</u>	<u>22</u>	<u>0-22</u>
<u>h. shell</u>	<u>22</u>	<u>22-44</u>
<u>Gray</u>	<u>10</u>	<u>44-74</u>
<u>Sand</u>	<u>32</u>	<u>74-106</u>
<u>Brown</u>	<u>11</u>	<u>106-117</u>
<u>Sand</u>	<u>53</u>	<u>112-170</u>
		<u>7/10</u>

Information upon completion of well:

(1) Diameter 2 inches.

(2) Total Depth 210 feet.

(3) Water Level 42 feet below top of ground.


(4) Cased to 310, Size 2"

(5) Screen: Size 10/32, Length 10'

(6) Were any formations sealed against pollution?
no.

If YES depth of formation _____
Why _____

Drillers Remarks: _____

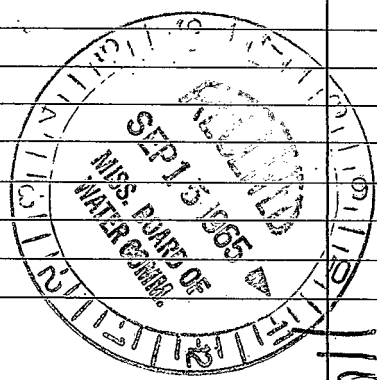

(Use Back Side)

Well No. 110

