

3
NEWTON
K 31
10-26-65

WATER WELL DRILLERS LOG

Date: 10-26, 1965, Driller: W. L. Skelley County, Newton
(Name)

(1) Owner of Land: J. M. Kerby
(Name)
Newton Miss
(Address)

(2) Location: W 1/4 SW 1/4, Sec 4 T6 R11,
3 miles N of Newton
(distance) (direction) (Nearest Town)

(3) Topography: (Hilly) (Flat) (Level)

(4) Purpose of Well: Domestic
(Domestic Irrigation
Municipal, Industrial, Other)

Description & Color of Materials Sand, Clay, Red Clay, Shell, etc.	Thick- ness Feet	Depth Feet
Clay	21	0-21
Blue + Shell	32	21-53
Brown	21	53-74
Gray + Sandy	21	74-95
Brown	33	95-127
Sand	43	127
		170

Information upon completion of well:

(1) Diameter 2 inches.

(2) Total Depth 170 feet.

(3) Water Level 75 feet below top of ground.

(4) Cased to 170, Size 2"


(5) Screen: Size 60# Length 10'

(6) Were any formations sealed against pollution?
yes, no.

If YES depth of formation _____

Why _____

Drillers Remarks: _____

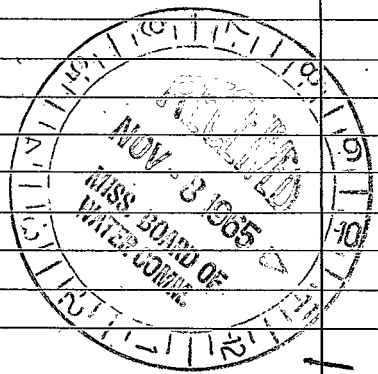

(Use Back Side)

Well No. 117

