

3 NEWTON
K32

WATER WELL DRILLERS LOG

Date: 6-17, 1966, Driller: U. L. Middle County, Newton
6-17-66 (Name)

(1) Owner of Land: Minnie Taylor
(Name)
Decorah, Miss
(Address)

(2) Location: NW 1/4, NW 1/4, Sec. 3 T6 R11
6 miles N, of Newton
(distance) (direction) (Nearest Town)

(3) Topography: v
(Hilly) (Flat) (Level)

(4) Purpose of Well: Domestic
(Domestic Irrigation
Municipal, Industrial, Other)

| Description & Color of Materials Sand, Clay, Red Clay, Shell, etc. | Thick- ness Feet | Depth Feet |
|---|------------------------|----------------|
| <u>Red clay</u> | <u>43</u> | <u>0-43</u> |
| <u>Blue + shell</u> | <u>42</u> | <u>43-85</u> |
| <u>Brown</u> | <u>52</u> | <u>85-137</u> |
| <u>B + sand</u> | <u>21</u> | <u>137-158</u> |
| <u>Sand</u> | <u>32</u> | <u>158-190</u> |


Information upon completion of well:

- (1) Diameter 2 inches.
- (2) Total Depth 190 feet.
- (3) Water Level 115 feet below top of ground.
- (4) Cased to 190, Size 2".
- (5) Screen: Size 60 Mesh Length 10'.
- (6) Were any formations sealed against pollution?
no

If YES depth of formation _____

Why _____

Drillers Remarks: _____

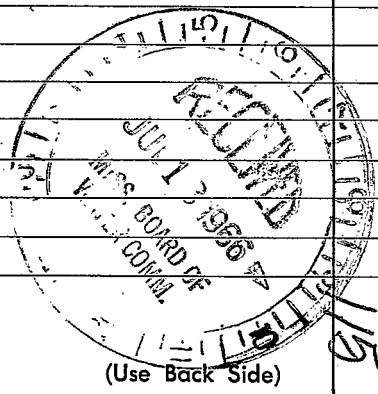

Well No. 115

