

MISSISSIPPI  
 BOARD OF WATER COMMISSIONERS  
 416 North State Street  
 Jackson, Mississippi 39201

WATER WELL DRILLERS LOG

Newton  
K33  
3-67

3129.67 19 MCDONALD + HILL NEWTON  
 date well completed firm name county well located

LANDOWNER: LT WARREN

description of formations encountered

from to

R#1 NEWTON

CLAY SHALE

0 18

SANDY SLT LIGNITE

18 75

SANDY

75 85

SAND NO 12

85 120

(mailing address)

WELL LOCATION:

sec. 15 T. 10 N R. 11 E  
 S W  
2 miles NORTH of NEWTON  
 (distance) (direction) (nearest town)

WELL PURPOSE: HOME  
 (home, irrigation, municipal, industrial)

WELL COMPLETION DATA:

(1) diameter (inches) 3 3/4 TEST HOLE

(2) total depth (feet) 132

(3) static water level (feet) 57 below above top of ground.

(4) casing CALL 128  
 (material) (depth)

NO if telescope see back.  
 (size)

(5) screen 5' 128'  
 (length) (depth to top)

2" BRASS  
 (size) (material)

(6) pump 1/2 JET 6  
 (HP) (yield gpm)


230  
 (type power)

(7) electric log NO  
 (yes or no)

NO  
 (organization running log)

(8) how well bottom plugged VALVE

DRILLERS REMARKS:

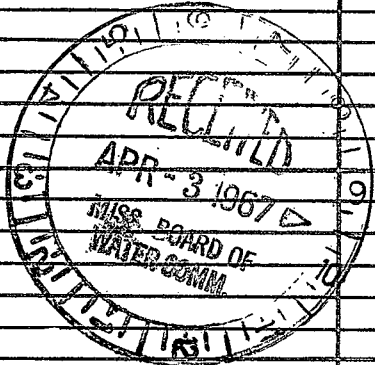

If well telescopes please sketch and show depths.

GROUND LEVEL

X			

SECTION 15

Please indicate well location X.

ADDITIONAL INFORMATION

If more than one screen, show locations of each on sketch.