

Newton
K34
3-67

MISSISSIPPI
BOARD OF WATER COMMISSIONERS
416 North State Street
Jackson, Mississippi 39201

WATER WELL DRILLERS LOG

3-7 1967 Just Drilling Newton
date well completed firm name county well located


LANDOWNER: Bill Myers
Rt 1 Box 156C
Lawrence Miss
(mailing address)

description of formations encountered	from	to
<u>red clay</u>	<u>0</u>	<u>8</u>
<u>red sand & clay</u>		<u>20</u>
<u>clay + shells</u>		<u>40</u>
<u>fine sand</u>		<u>61</u>
<u>sand</u>		<u>84</u>

WELL LOCATION:
29 sec 60 T 60 S R EO W
2 miles West of Newton
(distance) (direction) (nearest town)

WELL PURPOSE: Home
(home, irrigation, municipal, industrial)

- WELL COMPLETION DATA:
- (1) diameter (inches) 2"
 - (2) total depth (feet) 84
 - (3) static water level (feet) 39 below above top of ground.
 - (4) casing Galv., 79,
(material) (depth)
2"
(size) if telescope see back.
 - (5) screen 5ft, 50
(length) (depth to top)
2", Cpm Brass
(size) (material)
 - (6) pump 3, 1000 ? gph
(HP) (yield gpm)
elist
(type power)
 - (7) electric log No
(yes or no)

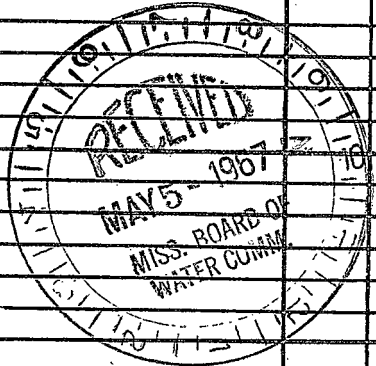

(organization running log)
(8) how well bottom plugged Backwash
Value

DRILLERS REMARKS:

If well telescopes please sketch and show depths.

GROUND LEVEL

X			

SECTION 29

Please indicate well location X.

ADDITIONAL INFORMATION

If more than one screen,
show locations of each on sketch.