

K 35  
6-9-62

WATER WELL DRILLERS LOG

Date: 6-9, 1962, Driller: U. L. Shelton Newton  
(Name)

(1) Owner of Land: O. C. Craven  
(Name)

Lanier  
(Address)

(2) Location: SE 1/4, NE 1/4, Sec 70 T 6 R 11

3 miles West, of Newton  
(distance) (direction) (Nearest Town)

(3) Topography: U  
(Hilly) (Flat) (Level)

(4) Purpose of Well: Domestic  
(Domestic Irrigation  
Municipal, Industrial, Other)

Description & Color of Materials  
Sand, Clay, Red Clay, Shell, etc.

Thick-  
ness  
Feet

Depth  
Feet

Coar R 10 0-12  
Blak B 1.5 12-32  
Blak Sandy 4.3 22-65  
Sand 2.5 65-90

Information upon completion of well:

(1) Diameter 3 1/2 inches.

(2) Total Depth 90 feet.

(3) Water Level 16 feet below top of ground.

(4) Cased to 90, Size 2"

(5) Screen: Size 2", Length 6


(6) Were any formations sealed against pollution?

yes,  no.

If YES depth of formation \_\_\_\_\_

Why \_\_\_\_\_

Drillers Remarks: \_\_\_\_\_

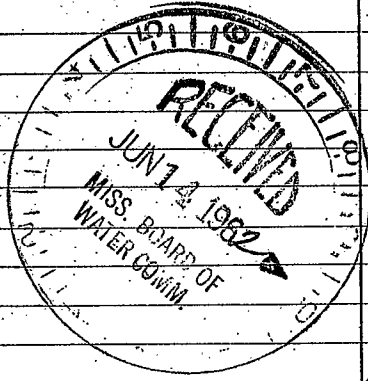

(Use Back Side)

37

Well No.

