

K36
6-22-62

WATER WELL DRILLERS LOG

4

Date: 6-22, 1962, Driller: U. L. Webb County Newton
(Name)

(1) Owner of Land: Floyd M. Lee
(Name)
Newton Miss
(Address)

(2) Location: NE 1/4, NE 1/4, Sec. 28 T. 6 R. 11 E
1 miles NW of Newton
(distance) (direction) (Nearest Town)

(3) Topography: L
(Hilly) (Flat) (Level)

(4) Purpose of Well: Domestic
(Domestic Irrigation
Municipal, Industrial, Other)

| Description & Color of Materials Sand, Clay, Red Clay, Shell, etc. | Thick- ness Feet | Depth Feet |
|---|------------------------|----------------|
| <u>Clay</u> | <u>8</u> | <u>0-8</u> |
| <u>Blue</u> | <u>124</u> | <u>8-22</u> |
| <u>Blue Shell</u> | <u>67</u> | <u>22-89</u> |
| <u>Brown</u> | <u>84</u> | <u>87-171</u> |
| <u>Sand</u> | <u>60</u> | <u>171-231</u> |

Information upon completion of well:

(1) Diameter 3 1/2 inches.

(2) Total Depth 241 feet.

(3) Water Level 45 feet below top of ground.


(4) Cased to 241, Size 2"

(5) Screen: Size 2" 80% Length 10'

(6) Were any formations sealed against pollution?
no

If YES depth of formation: _____
Why: _____

Drillers Remarks: _____

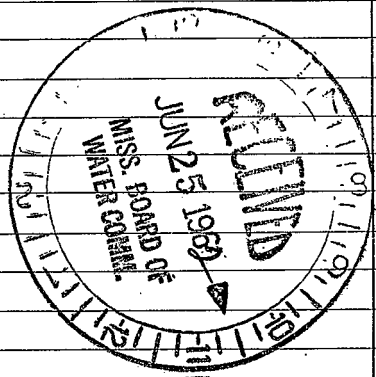

(Use Back Side)

41

Well No.

OF MEDICINE AND NATURAL PHILOSOPHY

FOR THE YEAR 1780

LONDON: Printed by J. BARNARD, at the Theatre-French, in Pall-mall.

1780

By Authority, W. BARRINGTON, Printer, in Pall-mall.

1780

1780

