

NEWTON  
 3 K 29  
 3-68

MISSISSIPPI  
 BOARD OF WATER COMMISSIONERS  
 416 North State Street  
 Jackson, Mississippi 39201

WATER WELL DRILLERS LOG

3-5 1968 U.L. Welch Newton  
 date well completed firm name county well located

LANDOWNER: Robert Parker  
 Newton  
 Miss.  
 (mailing address)

description of formations encountered	from	to
bed clay	0	22
Gandy clay	22	32
Gandy	32	54

WELL LOCATION:  
 sec. 21 T. 4 N R. N E  
 S W  
 2 1/2 miles NW of Newton  
 (distance) (direction) (nearest town)

WELL PURPOSE: home  
 (home, irrigation, municipal, industrial)


- WELL COMPLETION DATA:
- (1) diameter (inches) 2"
  - (2) total depth (feet) 64
  - (3) static water level (feet) 28 below top of ground.
  - (4) casing Galv steel  
 (material) (depth)  
 \_\_\_\_\_ if telescope see back.  
 (size)
  - (5) screen 5"  
 (length) (depth to top)  
 2"  
 (size) (material)
  - (6) pump 1/2 300  
 (HP) (yield gpm)  
Electric  
 (type power)
  - (7) electric log \_\_\_\_\_  
 (yes or no)  
 \_\_\_\_\_  
 (organization running log)
  - (8) how well bottom plugged no

DRILLERS REMARKS:



If well telescopes please sketch and show depths.

GROUND LEVEL

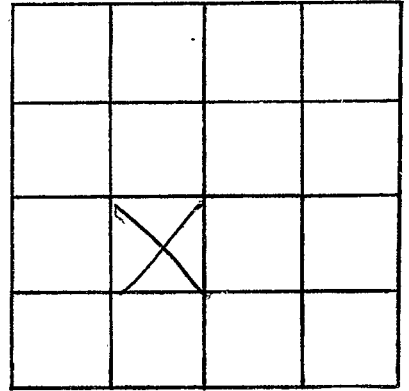

SECTION \_\_\_\_\_

Please indicate well location X.

ADDITIONAL INFORMATION

If more than one screen,  
show locations of each on sketch.