

NEWTON
3 K40
3-68

MISSISSIPPI
 BOARD OF WATER COMMISSIONERS
 416 North State Street
 Jackson, Mississippi 39201

WATER WELL DRILLERS LOG

3-14 1968 U. R. Shelch Newton
 date well completed firm name county well located

LANDOWNER: Ray Fisackerly
 Newton Miss

description of formations encountered	from	to
Red Clay	0	22
S Clay	22	32
Sand	32	62

(mailing address)

WELL LOCATION:

sec 21 T. 6 N R. 11 E
 S W
 2 1/2 miles N W of Newton
 (distance) (direction) (nearest town)

WELL PURPOSE:

(home, irrigation, municipal, industrial)

WELL COMPLETION DATA:

- (1) diameter (inches) 2"
- (2) total depth (feet) 62
- (3) static water level (feet) 32 below top of ground.

- (4) casing Gal steel, (material) (depth)

(size) if telescope see back.

- (5) screen 5' (length), (depth to top)

2" (size), Brass (material)

- (6) pump 1/2 (HP), 300 (yield gpm)


elec (type power)

- (7) electric log (yes or no)

(organization running log)


- (8) how well bottom plugged

DRILLERS REMARKS:

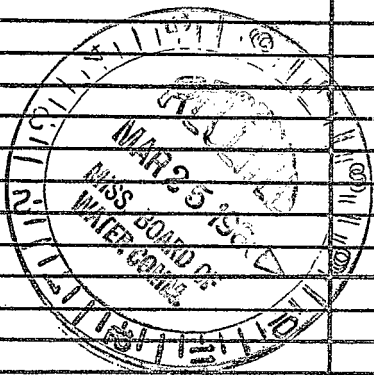

If well telescopes please sketch and show depths.

GROUND LEVEL

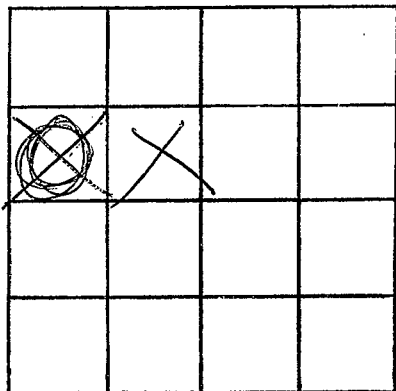

SECTION _____

Please indicate well location X.

ADDITIONAL INFORMATION

If more than one screen,
show locations of each on sketch.