

NEWTON
K 40
4-68

MISSISSIPPI
BOARD OF WATER COMMISSIONERS
416 North State Street
Jackson, Mississippi 39201

WATER WELL DRILLERS LOG

4-15 1968 Layne-Central Co. Newton
date well completed firm name county well located

LANDOWNER:

City of Newton, Miss.

(mailing address)

WELL LOCATION:

across the street
sec 34 T 6 N R 11 E
from water works

miles of (distance) (direction) (nearest town)

WELL PURPOSE: Municipal
(home, irrigation, municipal, industrial)

WELL COMPLETION DATA:

- (1) diameter (inches) 18"
- (2) total depth (feet) 311'
- (3) static water level (feet) 100' below above top of ground.
- (4) casing Steel (material), 260' (depth),
18" (size) if telescope see back.
- (5) screen 40' (length), 265' (depth to top),
10" (size), BRONZE (material)
- (6) pump 50 (HP), (yield gpm)
Electric (type power)
- (7) electric log No (yes or no)
(organization running log)
- (8) how well bottom plugged Valve


description of formations encountered

from to

Top Soil	0	4
Yellow Clay	4	18
Hard Blue Clay	18	201
Sandy Clay	201	234
Sand	234	310
Clay streaks of fine sand	310	324


DRILLERS REMARKS:

Pump not set as of this date,
Final test not run

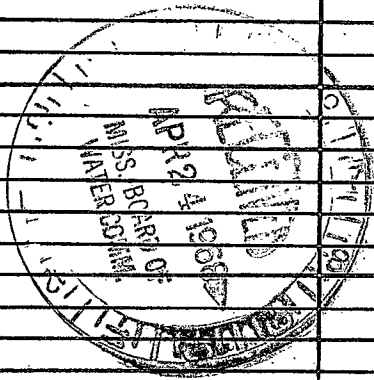

If well telescopes please sketch and show depths.

GROUND LEVEL

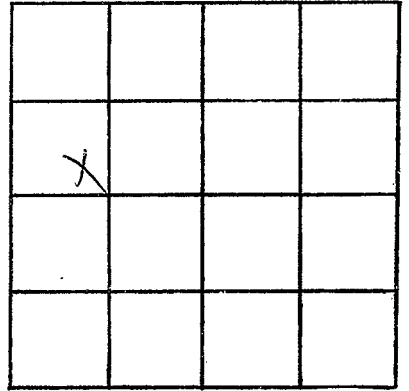

SECTION _____

Please indicate well location X.

ADDITIONAL INFORMATION

If more than one screen,
show locations of each on sketch.