

**MISSISSIPPI  
BOARD OF WATER COMMISSIONERS**  
416 North State Street  
Jackson, Mississippi 39201

**WATER WELL DRILLERS LOG**

Newton  
K 93  
7-68

7-26-68 19 MCDONALD & HILL NEWTON  
date well completed firm name county well located

LANDOWNER: J. H. McKinney  
RR 1 NEWTON  
  
(mailing address)

description of formations encountered	from	to
<u>CLAY SAND</u>	<u>0</u>	<u>25</u>
<u>SHALE</u>	<u>25</u>	<u>60</u>
<u>FINE SAND</u>	<u>60</u>	<u>120</u>
<u>SAND 10 = 12</u>	<u>120</u>	<u>132</u>

WELL LOCATION:  
sec. 13 T. 6 N R. 11 E  
3 miles NORTH of NEWTON  
(distance) (direction) (nearest town)

WELL PURPOSE: HOME  
(home, irrigation, municipal, industrial)


- WELL COMPLETION DATA:
- (1) diameter (inches) 4"
  - (2) total depth (feet) 132
  - (3) static water level (feet) 46 below top of ground.
  - (4) casing BLK, 115',  
(material) (depth)  
4" if telescope see back.  
(size)
  - (5) screen 6, 126'  
(length) (depth to top)  
2", PVC PLASTIC  
(size) (material)
  - (6) pump 1/2, 10  
(HP) (yield gpm)  
220  
(type power)
  - (7) electric log NO  
(yes or no)  
  
(organization running log)
  - (8) how well bottom plugged VALVE

JUL 30 1968  
MISS. BOARD OF  
WATER COMM.

DRILLERS REMARKS:

If well telescopes please sketch and show depths.

GROUND LEVEL

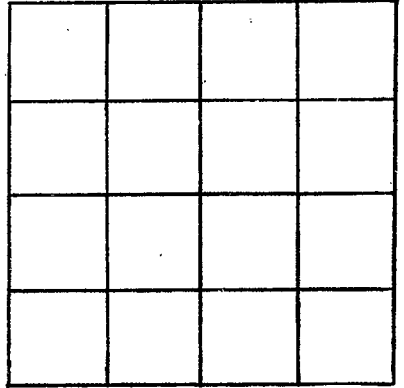

SECTION \_\_\_\_\_

Please indicate well location X.

ADDITIONAL INFORMATION

If more than one screen, show locations of each on sketch.